

Barber

KANSAS


SECTION 19 TOWNSHIP 32 RANGE 10W

WELL NO. #1 Eckert

COMPANY Bennett & Roberts

NORTH

C NW/4

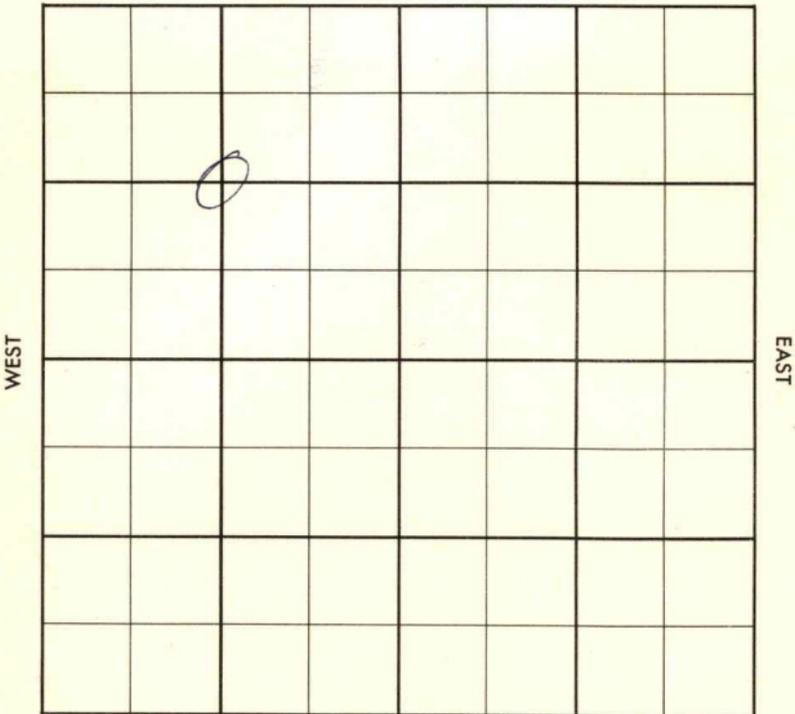

WEST

EAST

SOUTH

County Barber Elev. 1484
 Sec. 19 Twp. 32 Rge. 10W
 Company Bennett & Roberts
 Farm Name Eckert No. 1

TOPS	DEPTH	LOG	DATUM
Anh.			
Top.			
H.	3536		
Tr.			
Dg.	3636		
Bl.			
L.	3713		
K.C.			
B.K.C.	4185		
Ce.			
C. <u>Horn sd</u>	4380		
M.	4398		
M.			
K.			
Mz.			
Me.			
V.			
S.			
S.			
A.			
R.			
PE.			
G.			
T.D.	4490		

Loc. in Sec.

C NW/4


Geol.

Contr.

Co. Tools

Pool

McGuire

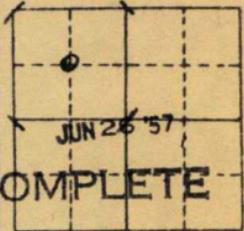

Date Comm. 5-1-57 Magnolia (FO) gas rights

8" @ 207/200, Drlg. 2707 MAY 15 '57

DST 3637-90 1hr 1650' SW

BHP 1395 @ 408/ MAY 22 '57

DST 4400-15 4hr 1hr G/3"

ga 500 MCF /15" ga 440'

MCF /30" ga 420 MCF /20"

rec 20' GCM BHP 1655/30"

DST 4415-35 4hr 80" G/20"

TST. rec 45' OCM BHP 1405

DST 4435-74

5/2 4490 / WOCT MAY 29 '57 JUN 5 '57

JUN 12 '57 JUN 19 '57 CO 16/ 4410-14

no show $\frac{1}{2}$ ga 175 MCFW
 FRAC 4x4 \uparrow ga 130
 MCFW + Ld of 800# TP 650#
 CSO. op Flow 3,800 MCFpd
 JUN 26 '57 complete op Flow
 3,800 MCFpd

Co.

County Barber Elev. _____
 Sec. 19 Twp. 32 Rge. 10W
 Company Bennett & Roberts
 Farm Name Eckert No. 1

TOPS	DEPTH	LOG	DATUM	Loc. in Sec.
Anh.				C NW/4
Tp.				
H.				
Tr.				
Dg.				
Bl.				
L.				Geol. _____
K.C.				Contr. _____
B.K.C.				
Ce.				Co. Tools _____
C.				
M.				Pool _____
M.				McGuire
K.				
Mz.				
Me.				
V.				
S.				
S.				FIRST REPORT
A.				
R.				
Pe.				
G.				
T.D.				

Date Comm. 5-1-57 Magnolia (FO) gas rights ^{NW}
8" @ 207/200, Drlg. 2707

27

5