
Barber

KANSAS

SECTION 19 TOWNSHIP 32S RANGE 10W

WELL NO. #1 Miller McGuire

COMPANY Wold Wide Petr.

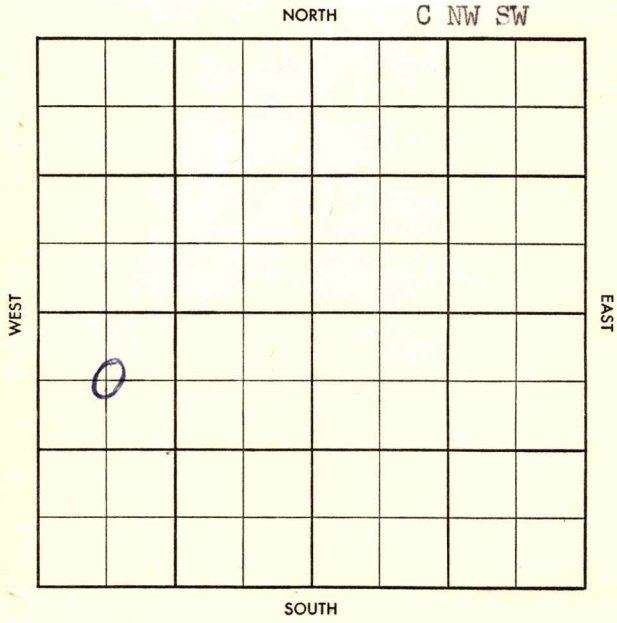

FORM 504-3 SUNRAY

S-513-A

FIRST REPORT

NOV 20 '57

CO. Barber ELEV.

SEC. 19 TWP. 32 RGE. 10W

COMPANY World Wide Pet. NO. 1

FARM Miller McGuire Magnolia (FO)

LOC. C NW SW

GEOL.

CONTR. ~~Gene Walker~~

POOL ~~Goemann~~

SPUD 11/17/57

8" @ 195 w/200

CO. LSE. NO. SEC. TWP. RGE.

27

27

S–513-A

CO. Barber ELEV. 1486DF

SEC. 19 TWP. 32 RGE. 10W

COMPANY World Wide Pet. NO. 1

ABANDONED

DEC 11 '57

FARM Miller McGuire Magnolia (FO)

LOC. C NW SW

GEOL.

CONTR. Gene Walker

POOL Goemann

SPUD 11/17/57

8" @ 195 w/200

~~[illegible]~~ Ø 3726

DEC 4 '57 Ø ~~4385~~

in 4442'. DST

4387-4424 60"

105' HgCm FP

715-155 BHP 355/30"

DST 4450-84 60" g/11"

ga 70 mcf ~~[illegible]~~

140' SwCm FP 220-230

BHP 1495/30 TD 4484

Log tops H 3550 TR 3572

L 3730 Burg Sd 4400 M

4418

D&A

CO. LSE. NO. SEC. TWP. RGE.