


DX 78-1 Barber

Section 20 Township 32 Range 10W

Well No. #1 M. D. McGuire


Company Eure Oil

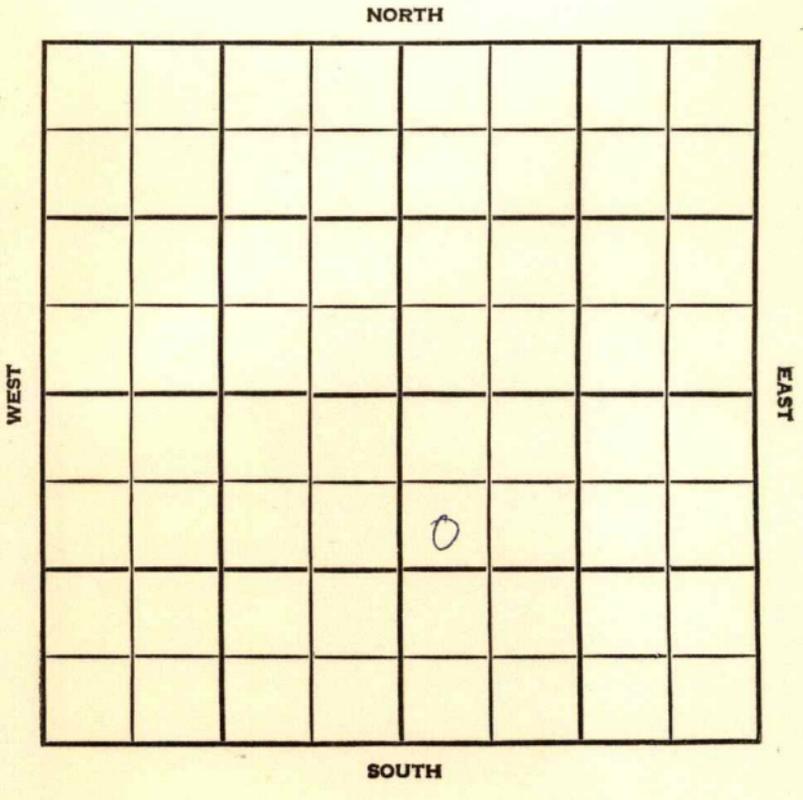

County Barber Elev. 1461 DF
 Sec. 20 Twp. 32 Rge. LOW
 Company Pure Oil
 Farm Name M. D. McGuire No. 1

TOPS	DEPTH	LOG	DATUM
Anh.			
TP.			
H.	3510	3510	
Tr.			
Dg. <u>20</u>		3553	
Bt. <u>D95d</u>		3641	
L.	3694	3694	
K.C.		3979	
B.K.C.		4177	
Ce.			
C.			
M.	4402	4402	
M.			
K.			
Mz.			
Mo.			
V.			
S.			
S.			
A.			
R.			
PE.			
G.			
TD	4444		

Loc. in Sec. _____
 SW NW SE
 Geol. _____
 Contr. _____
 Mull Drlg.
 Pool
 Goemann

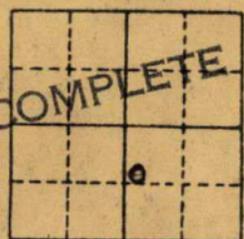

Date Comm. JUL 1 1 1956
M I R JUN 13 '56 6-5-56 8 260' / 200 SL
3072 JUN 20 '56 DST 4404-31 1hr
see 30' Md BHP 25/20" JUN 27 '56
DST 4 1/2 @ 4444 / 250 CO
DST 4404-44 1hr. see 5' OE 6CM
+ 90' HOE 2CM BHP 192/20"
CO 4441 40/4430-40 1/4 Frac
Flwg 1 Boph + 1 Mill CFG. JUL 3 '56
9a 1,420 MCFG Pd no oil SI. JUL 11 '56
S.I. Gas well.

Co.
 Sec.
 No.
 Sec.
 T.
 R.

