


Section 20 Township 32 Range 10W

Well No. #1 H.K. McKeever

Company Magnolia

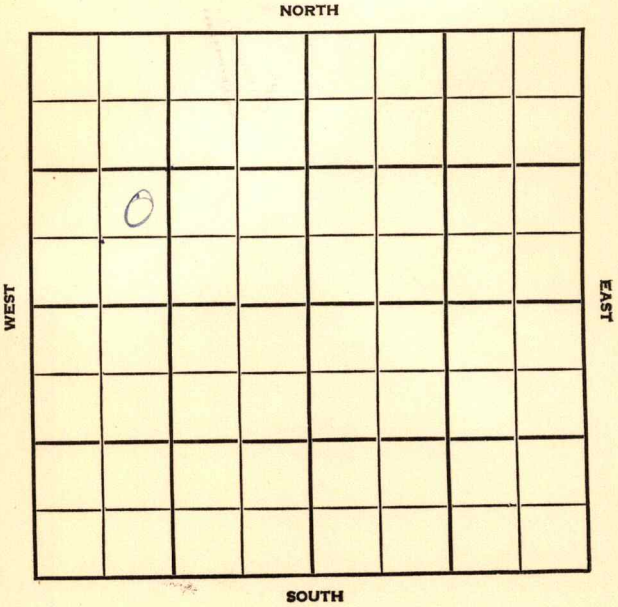

County Barber

Elev.

1483Sec. 20

Twp.

32

Rge.

10WCompany MagnoliaFarm Name H.K. McKeeverNo. 1

TOPS

DEPTH

LOG

DATUM

Loc. in Sec.

Anh.

Tp.

H.

Tr.

Dg.

Bl.

L.

K.C.

B.K.C.

Ce.

C.

M.

M.

K.

Mz.

Mg.

V.

S.

S.

A.

R.

Pe.

G.

T.D.

NE SW NW

Geol.

Contr.

Graham-MichaelisToolsPoolGoemann

DEC 5 1956

FIRST REPORT

Date Comm. Spd/ 12-1-569" @ 280 w/275, Drlg. 856

27

County Barber Elev. 1483  
 Sec. 20 Twp. 32 Rge. 10W  
 Company Magnolia  
 Farm Name H.K. McKeever No. 1

| TOPS             | DEPTH | LOG  | DATUM | Loc. in Sec.     |
|------------------|-------|------|-------|------------------|
| Anb.             |       |      |       | NE SW NW         |
| Tr.              |       |      |       |                  |
| H.               | 3518  | 3515 |       |                  |
| Tr.              |       |      |       |                  |
| Dg.              | 3572  | 3569 |       |                  |
| BL.              |       |      |       |                  |
| L.               | 3700  | 3700 |       |                  |
| K.C. <u>Borg</u> | 4368  | 4369 |       | Geol.            |
| B.K.C.           |       |      |       | Contr.           |
| Ce.              |       |      |       |                  |
| C.               |       |      |       | Graham-Michaelis |
| M.               | 4383  | 4383 |       | Tools            |
| M.               |       |      |       | Pool             |
| K.               |       |      |       | Goemann          |
| Mz.              |       |      |       |                  |
| Me.              |       |      |       |                  |
| V.               |       |      |       |                  |
| S.               |       |      |       |                  |
| S.               |       |      |       |                  |
| A.               |       |      |       |                  |
| R.               |       |      |       |                  |
| Pe.              |       |      |       |                  |
| G.               |       |      |       |                  |
| T.D.             | 4460  |      |       |                  |

COMPLETE  
JAN 16 '57

Date Comm. Spd/ 12-1-56

9" @ 280 w/275, Drlg. 856 DEC 12 '56 113480

DEC 12 '56 DST 4386-4412 1hr G/2"

9a 1.250 MCFG rec 60' GCM

FP 125-125 BHP 1590/20"

5 1/2 @ 4459/200 WOC DEC 26 '56 GRNL

100/4388-4408 1 1/2 Frac 25 X 25

9a 3.310 MCFG TP 870 CP 1050

9a 3.120 MCF 2 1/4" ch TP 820

CP 980 #

JAN 2 '57

JAN 9 '57

JAN 15 '57

GR F/W 5, 235 MCLG

SIBHP 1645 SITP 1465

SICP 1482