

Barber

KANSAS

SECTION 10 TOWNSHIP 32 S RANGE 10 W

WELL NO. # 1 Doan-Smith


COMPANY N.C.R.A. & Sunray Mid-Continent

NORTH

W/2 E/2 SW

WEST

EAST

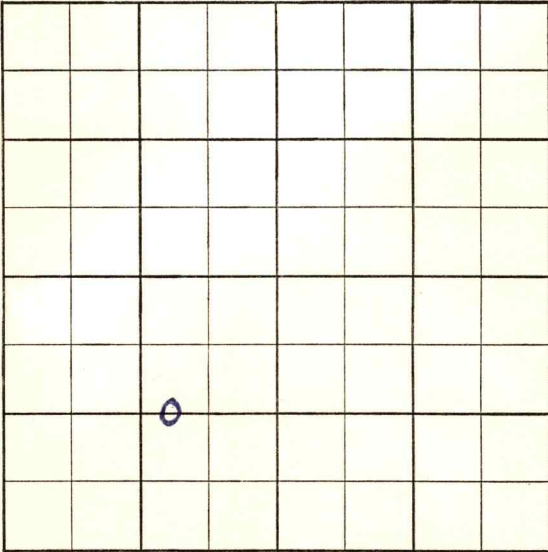

SOUTH

HOT FILE

Barber

KANSAS

SEC.

TWP.

R.

10

32 S

10 W

WELL NO.

1 Dohm-Smith

FARM

COMPANY

N.C.R.A. & SDX

(DEVELOPMENT-BOC)

CONTRACTOR

Gabbert-Jones

Sharon-NW

____ FT. FROM N. LINE

____ FT. FROM S. LINE

____ FT. FROM E. LINE

____ FT. FROM W. LINE

NORTH

WEST

EAST

SOUTH

W/2 E/2 SW

Oper. Agt - SDX + N.C.R.A.

ELEVATION

1958

1494' DF

REPORT

(WH7-EX29)

2/26

4150' Miss. Test

Location

(FR Tkt)

3/3

MIRT

(DR#43)

3/4

"

3/5

"

3/6

Spudded 3-2-58

Drlg. 1130'

3/7

Drlg. 1720'

3/10

Drlg. 2090'

3/11

Drlg. 2660'

3/12

TD 2660'. NR

3/13

Drlg. 3760'

3/14

TD 3760'. NR

3/17

Drlg. 4255'

3/18

Drlg. 4375'. Taking DST

3/19

TD 4450' P & A

(DR#55)

3/19

~~TD~~ Spud 3-3-58

8-5/8" @ 220/175

Tops: Anh 1190', H. 3489', Tr. 3528'

Dg 3552', Sd 3613', L. 3674', BKC 4164'

M. 4357'

DST 4359-75, 60", 13' M. FP 32332

BHP 195-120#

DST 4375-95, 60", G/5" TSTM(est 20 MCF

rec 60' GCM. BHP 1722-1250#. FP 105-

285#.

OVER

1958
3/19

(Information continued)

DST 4395-4415, 60", 1560' GIP, 33'
OCM, 120' oil, specked w/mud.

BHP 1680-870#. FP 40-55#. Ran logs.

TD 4450' D & A

(Scout Completion Ticket)

ABANDONED

Twp N Pool N

Co. X Facet N

S-513.B

County Barber

Elev. 14940 F

Sec. 10 Twp 32

Rge. LOW

N.C.R.A. & Sunray Mid-Continent

Dohm-Smith

No. 1

TOPS	DEPTH	LOG	DATUM
Anh.	<u>1190</u>		
Tp.			
H.	<u>3489</u>		
Tr.	<u>3528</u>		
Dg.	<u>3552</u>		
<u>sd</u>	<u>3613</u>		
L.	<u>3674</u>		
K.C.			
B.K.C.	<u>4164</u>		
Ce.			
C.			
M.	<u>4357</u>		
M.			
K.			
Mz.			
Mq.			
V.			
S.			
S.			
A.			
R.			
Pf.			
G.			
T.D.	<u>4450</u>		

Loc. in Sec.

W/2 E/2 SW

Geol.

Contr.

Gabbert-Jones

Pool

Sharon NW

ABANDONED

MAR 19 1958

Date Comm. 3-3-58

Location 85° 220/175 Ø 1130

MAR 12 58 Ø 3930 MAR 19 58 X TOPS DST

4359-75 60" 13'M FP 32-32

BHP 195-120 DST 4375-95 60"

g. 1/5" TSTM (ext 20 m) rec 60'

gcm BHP 1722-1250 FP 105-285 DST

4395-4415 60" 1560' gip 33' ocm 120'

oil SPK WM BHP 1680-870 FP 40-55

run log

D & A

County Barber Elev. _____
 Sec. 10 Twp. 32 Rge. 10W
 Company N.C.R.A. & Sunray Mid-Continent
 Farm Name Dohm-Smith No. 1

TOPS	DEPTH	LOG	DATUM
Anh.			
Tp.			
H.			
Tr.			
Dg.			
B.L.			
L.			
K.C.			
B.K.C.			
Ce.			
C.			
M.			
M.			
K.			
Mz.			
Mq.			
V.			
S.			
S.			
A.			
R.			
Pf.			
G.			
T.D.			

Loc. in Sec. _____

W/2 E/2 SW

Geol. _____

Contr. _____

Gabbert-Jones

Pool _____

Sharon NW

FIRST REPORT

FEB 26 '58

0

Date Comm. _____

Location

MAR 3 1958
 M. M.