


Barber

KANSAS

SECTION 12 TOWNSHIP 32 RANGE 10W

WELL NO. #2 Stone


COMPANY Pickrell Drlg.

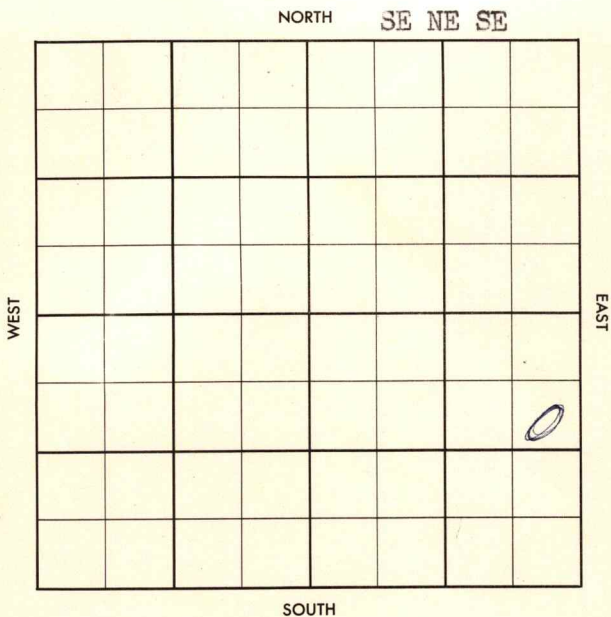

County Barber Elev. _____ Co.
 Sec. 12 Twp. 32 Rge. 10W
 Company Pickrell Drlg.
 Farm Name Stone No. 2

TOPS	DEPTH	LOG	DATUM	Loc. in Sec.
Anh.				SE NE SE
TP.				
H.				
Tr.				
Dg.				
BL.				
L.				Geol.
K.C.				Contr.
B.K.C.				Co. tools
Ce.				Pool
C.				Sharon
M.				
M.				
K.				
Mz.				
Me.				
V.				
S.				
S.				
A.				
R.				
Pe.				
G.				
T.D.				

Date Comm. 1-23-57
8" @ 160/140 drlg. 2800

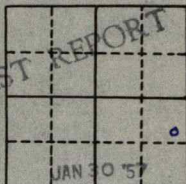

~~27~~

County

Barber

Elev.

1463

Sec.

12

Twp.

32

Rge.

LOW

Company

Pickrell Drilling

Farm Name

Stone

No.

2

Co.

Lse.

No.

Sec.

T.

R.

TOPS

DEPTH

LOG

DATUM

Loc. in Sec.

Anb.

Tp.

H.

Tr.

Dg.

B.L.

L.

K.C.

B.K.C.

Ce.

C.

M.

M.

K.

Mz.

Mo.

V.

S.

S.

A.

R.

P.E.

G.

T.D.

SE NW SE

Geol.

Contr.

Co. tools

Pool

Sharon

ABANDONED

FEB 13 '57

Date Comm. 1-23-57

8" G 160/110

drill. 2800 FEB 6 '57

DST 4374-81 90" 925/25"

TSTM net 90' GCM-500 +120

0' GCM +105' Mdy oil +15'

Mdy wt FP 65-165 BHP 995

D ahead FEB 13 '57 DST 4382-4410

1hr 60' 50' GCM +420' Mdy wt

BHP 1560

D & A.