


Section 13 Township 32 Range 10 W
Well No. # 1 McKeever
Company Aurora & J-S-F

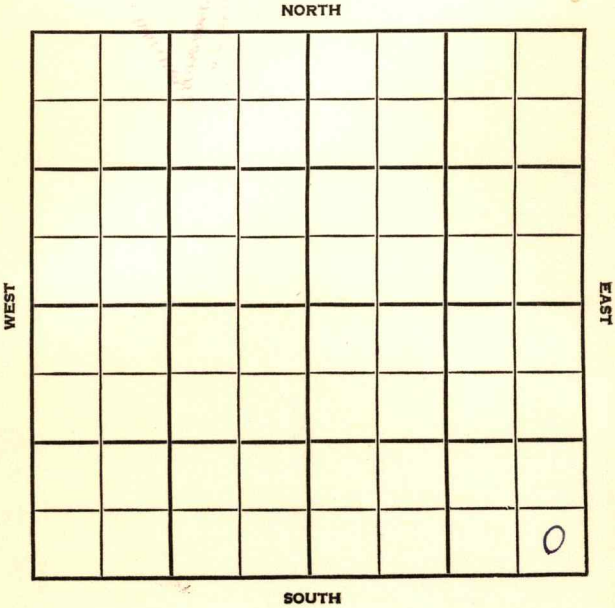

Barber KANSAS

SEC.	TWP.	R.
13	32	10W

WELL NO.

1 McKeever

FARM

COMPANY

Aurora & J-S-F

CONTRACTOR

J-S-F


Wildcat

_____ Ft. from N. Line

330 _____ Ft. from S. Line

330 _____ Ft. from E. Line

_____ Ft. from W. Line

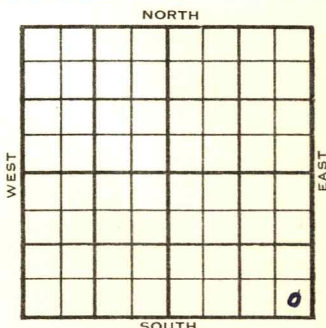

SE SE SE

1954

ELEVATION

1442'

REPORT

11/17
1955
3/2

Location

Spud 11-23-54 Oil well TD 4899
8" @ 204 Anhy 1150 neeb 3380
Doug 3431 Doug. sd. 3450' Lans 3603'
Miss. 4323'
DST 4327-31 open 1 hr rec 10' mud 0#
DST 4330-50 open 1 hr rec 60' 0 & GCM
30' HO & GCM, 30' muddy oil, 360#
DST 4350-70 open 1 hr. gas in 8 min
rec 4190' oil, 60' wtr. 1580#
DST 4370-4400 open 1 hr rec 3480' GCSW
1650# Kh. 4482' Misener 4633'
Viola 4636', Simp. 4715'
DST 4700-18 open 1 hr rec 840' SW
1900# Arb. 4868' TD 4899 5" @ 4460
41/4350-60 500 A S/15 BOPH
Comp. 40 BOPD 25% wtr.

COMPLETED

County Barber State Kansas

Sec. **13** (Blk. Twp.) **32** (Sur. Rge.) **10W** Map No.

Operator **Aurora & J-S-F**

Well No. 1 Farm McKeever

Elev.	Location	SE SE SE

330 Ft. From S Line SE

330 Ft. From R Line Quarter

1st. Report NOV 17 1954

Completion

Remarks


J-S_F - Contr.

Spudding Date _____

Drlg. Data Wildcat

Location

FABEN GILSTRAP

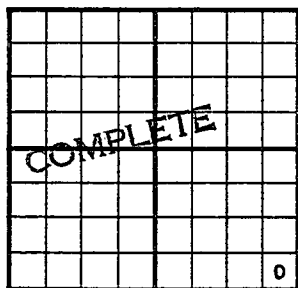County Barber State KansasSec. 13 (Blk. Twp.) 32 (Sur. Rge.) 10W Map No.Operator Aurora & J-S-FWell No. 1 Farm McKeeverElev. 1442 Location SE SE SE330 Ft. From S Line SE330 Ft. From E Line Quarter

1st. Report

Completion MAR 2 1955Remarks Sharon PoolJ-S-F - Contr.Spudding Date 11-23-54Drlg. Data Oil well TD 48998" @ 204 Anhy 1150 Heeb. 3380Doug. 3431 Doug. sd. 3450 Lans. 3603Miss. 4323 DST 4327-31 open 1 hr.Rec. 10' mud 0# DST 4330-50 open 1 hr.Rec. 60' o & gcm 30' ho & gcm 30' muddyoil 360# DST 4350-70 open 1 hr.gas in 8 min. Rec. 4190'-oil 60' wtr.1580# DST 4370-4400 open 1 hr.Rec. 3480' gcsw 1650# Kh. 4482Misener 4633 Viola 4636 Simp. 4715DST 4700-18 open 1 hr. Rec. 840' sw1900# Arb. 4868 TD 4899 5" @ 446041/ 4350-60 500 A S/ 15 bophComp. 40 bopd 25% wtr.

FABEN GILSTRAP