

Barber

KANSAS

13

32S

10W


SECTION _____ TOWNSHIP _____ RANGE _____

WELL NO. #2 McKeever

COMPANY Durbin Bond

NORTH

C E/2 NW SE

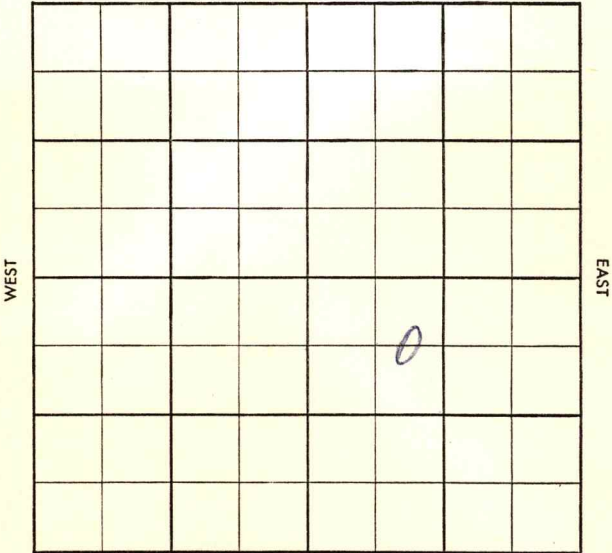

SOUTH

~~27~~

S-513-A

CO. Barber ELEV. _____
SEC. 13 TWP. 32 RGE. 10W
COMPANY Durbin Bond NO. 2

FIRST REPORT

OCT 30 '57

FARM McKeever

LOC. C E/2 NW SE

GEOL. _____
CONTR. D & M Drlg.
POOL Sharon #2
SPUD 10-28-57

8" @ 258, Drlg. 1500

CO.
LSE.
NO.
SEC.
TWP.
RGE.