


Barber

KANSAS

SECTION 23 TOWNSHIP 32 RANGE 10W

WELL NO. #1 Bissantz

COMPANY Durbin Bond

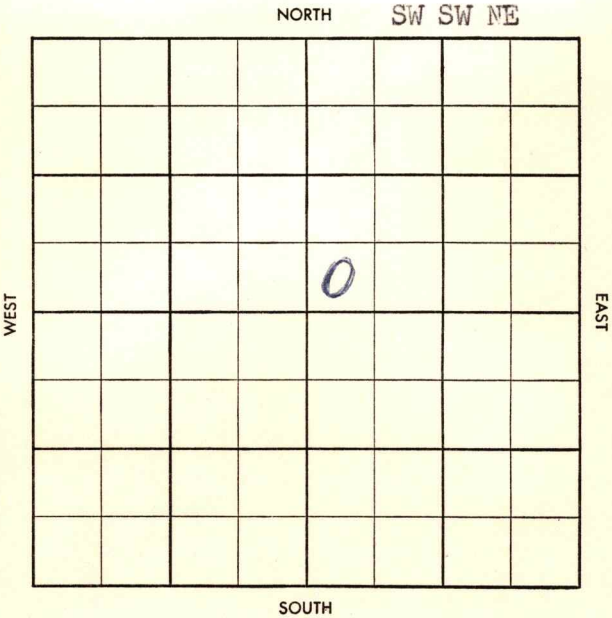

CO. Barber ELEV. _____
SEC. 23 TWP. 32 RGE. 10W
COMPANY Durbin Bond NO. 1

FIRST REPORT

FARM Bissantz
LOC. SW SW NE

GEOL. Chas. Brown

CONTR. D&M tools

POOL Sharon

SPUD 11/12/57

8" @ 255 w/200 Drlg.
3915.

~~27~~

CO.
LSE.
NO.
SEC.
TWP.
RGE.

CO. ~~Barber~~ ELEV. 14470
SEC. ~~23~~ TWP. 32 RGE. 10W
COMPANY Durbin Bond NO. 1

ABANDONED

NOV 27 '57

FARM Bissantz
LOC. SW SW NE

NO. SEC. TWP. RGE.

GEOL. Chas. Brown

CONTR. D&M tools

POOL Sharon

SPUD 11/12/57

8" @ 255 w/200 Drlg.
3915.

146 3412 BL3624
L 3646 M4347
DST 4348-55 90'
43 GCM LPO-25

BHP 1680/30" DST 4356
-40 120" 50' SGCM FP30
-30 BHP 460 DST (PKV)
4386-4208 90" 3470' SWFP
1260-1715 BHP 1730 RTP 4420

D&A