


Section 27 Township 32 Range 10 W

Well No. # 1 Pelton

Company Westpan Hydro-Carbon

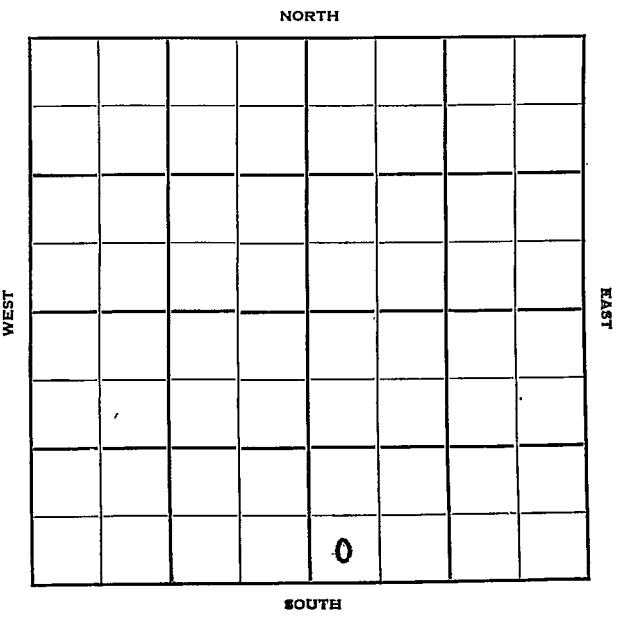

Sec. 27 Twp. 32 R. 10WWell No. #1 Pelton FarmWestpan Hydro-Carbon Company

Contractor

Wildcat


Ft. from N. Line

330 Ft. from S. Line

Ft. from E. Line

330 Ft. from W. Line

SW SW SE

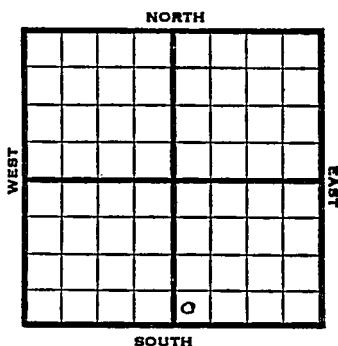

1952 Elev. 1424' REPORT

11/18 Spud 11-17-52
10" @ 287'

11/27 Drlg. 2650'

12/4 Drlg. 3600'

12/11 Knderhook 4540

Viola 4673-90'

DST. 4673'-90' 1 hr. 10' m

Simp 4753'

DST. 4753'-69' 1 hr. 490'

sulp & salt water. 1800# BHP.

Drlg. 4773'

12/11 Ø4585

12/18 Miss 4455 KH 4540 KH 1 4568 Chat 4650

V 4670 DST 4673-90 1 Hr. 10' M Simp

4753 DST 4753-69 1 Hr. 490' SW

1800# ARB 488 DST 4891-4900 RTD 1 Hr. 6

640' Sulp wtr 772# Schl. 5" @ 4470

CO

12/25 " " " "

1/1 NR

1/8 CO 4443 12/4392-96 FU 10' Oil 40' SW

6/4396-98 4/4390-92 S $\frac{1}{2}$ BF 3 Hrs.

S/6 BO 9 BW 15 Hrs. S/8 BO 31 BW

21 Hrs. sq all pers set retainer

4360 CO 113/4358-85

OVER

#1 Pelton

1953

1/22 Testing

1/29 NR

2/4 Spud 11-17-52

D&A

TD 4900

10" @ 287

Doug 3463

DST 3462-3507, opn $\frac{1}{2}$ hrs., rec.
1775' sw

Lans 3649, Miss 4356

DST 4358-70, opn $\frac{1}{2}$ hrs., rec.

10' sgcm, 350#

DST 4370-90, opn 18 mins., rec.

120' sgcm

DST 4390-4440, opn 1 hr., rec.

120' gcm, 270' ocm, 50% wtr.

270' sw, 1275#

Miss 4455, Kh. 4540, Kh. lime

4568, Chat. 4650, Viola 4670

DST 4673-90, opn 1 hr., rec.

10' mud, 33#

Simp 4753,

DST 4753-69, opn 1 hr., rec. 490'

sw, 1800#

Arb. 4888

DST 4891-4900, opn 1 hr., rec.

640' sul wtr., 772#

5" @ 4470

CO to 4443, 12/4392-96

FU 10' oil, 40' sw, 6/4396-98

4/4390-92, S/ $\frac{1}{2}$ bf 3 hrs.

S/6 bo 9 bw 15 hrs., S/8 bo 31

bw 21 hrs., SP 4360

113/4368-85, SSG, Hydro


S/59 $\frac{1}{2}$ bf 11 hrs., 41 bw

17 bo 1 mcfg

D&A

ABANDONED

County **Barber** State **Kansas**
 Sec. **27** (Blk.) **32** (Sur.) **10W** Map No.
 (Twp.)
 Operator **Westpan Hydro-Carbon**
 Well No. **1** Farm **Pelton**
 Elev. Location **SW SW SE**

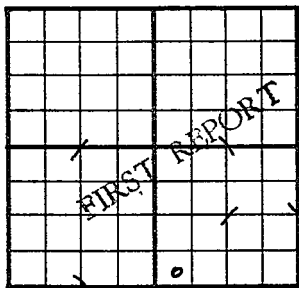

330 Ft. From **S** Line **SE**

330 Ft. From **W** Line Quarter

1st. Report **NOV 19 1952**

Completion

Remarks

Spudding Date **11-17-52**


Drlg. Data

Wildcat

10" @ 287

J. G. McGEHEE

County Barber State Kansas
 Sec. 27 (Blk. 32 (Sur. 10W Map No.
 Twp.) Rge.)
 Operator Westpan Hydro-Carbon
 Well No. 1 Farm Pelton
 Elev. 1424 Location SW SW SE

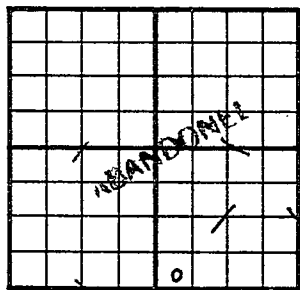

330 Ft. From S Line SE
330 Ft. From W Line Quarter
 Ist. Report
 Completion FEB 4 1953
 Remarks Wildcat

Spudding Date 11-17-52

Drlg. Data D & A TD 4900

10" @ 287 Doug. 3463 DST 3462-3507

open $\frac{1}{2}$ hr. Rec. 1775' sw Lans. 3649

Miss. 4356 DST 4358-70 open $\frac{1}{2}$ hr.

Rec. 10' sgcm 350# DST 4370-90

open 18 min. Rec. 120' sgcm DST 4390-

4440 open 1 hr. Rec. 120' gcm 270' ocm

50% wtr. 270' sw 1275# Miss. 4455

Kh. 4540 Kh. lime 4568 Chat. 4650

Viola 4670 DST 4673-90 open 1 hr.

Rec. 10' mud 33# Simp. 4753

DST 4753-69 open 1 hr. Rec. 490' sw

1800# Arb. 4888 DST 4891-4900

open 1 hr. Rec. 640' sul. wtr. 772#

5" @ 4470 CO to 4443 12/ 4392-96

J. G. McGEHEE

Drig. Data

FU 10' oil 40' sw 6/ 4396-98 Misc.

4/ 4390-92 S/ $\frac{1}{2}$ bf 3-hr. S/ 4390-92 Misc.

15 hr. S/ 8 bo 31 bw 21 hr. 4360-92 Misc.

113/ 4368-85 SSG Hyd. 4368-85 Misc.

11 hr. 41 bw 17 bo 1 mfg 4368-85 Misc.

D & A

FEB 10 1963