

Barber

KANSAS

SECTION 27 TOWNSHIP 32 RANGE 10 W

WELL NO. # 1 Harvey C. Pelton

COMPANY Mull Drlg.

NORTH

		0					

WEST

EAST

SOUTH

Barber

KANSAS

SEC. 27	TWP. 32	R. LOW
------------	------------	-----------

WELL NO.

#1 Harvey C. Pelton

FARM

COMPANY

Mull Drlg.

CONTRACTOR

Co. Tools

WILDCAT


_____ Ft. from N. Line

_____ Ft. from S. Line

_____ Ft. from E. Line

_____ Ft. from W. Line

NW NE SW

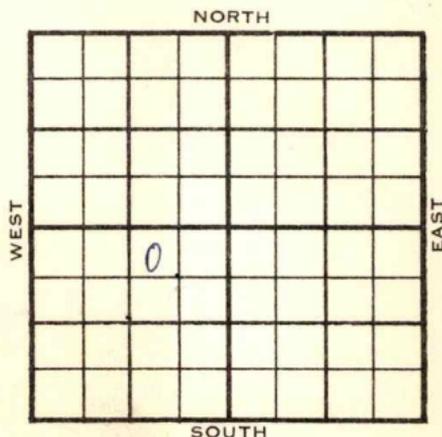

Sinc.-FO - Pure - DHM

1956	ELEVATION	REPORT
	1425'	
4-25	Comm. 4-23-56 8" @ 160 w/150 WOC	
5-16	DST 4353-71 op 2 hrs. 900' gas, rec. 51' GCM (SSO), BHP 340/20". DST 4371-86 op 2 hrs. rec. 62' GCM, (SSP) BHP 100/20" DST 4386-96 op 2 hrs. rec. 270' gas, rec. 30' ocm, / 30' mud, / 10' WM, BHP 110/20" DST 4355-4406 op 2 hrs. 180' gas, rec. 75' mud. FP 30-45#, BHP 145/45". DST 4402-16 op 2 hrs. rec. 150' GIP. rec. 300' Froggy oil / 180' oil & wtr. + 3275' wtr(SOC), FP 320-1755#, BHP 1965/20" D & A TD 4462'	
	H.	3412 3412
	Tr.	3430
	Dg.	3448 3449
	L.	3638 3639
	BKC	4150 4150
	M.	4354 4349

ABANDONED

27-32-10W

FORM 513-1 SUNRAY

FP 30-45 BHP 145/45"
DST 4402-16 2 hrs rec 150'
GIR rec 300' Frq oil +
180' oil c' wtr + 3275' wtr (SOC)
FP 320-1755 BHP 1965/20"

MAY 16 '56

D & A

County Barber Elev. _____
 Sec. 27 Twp. 32 Rge. LOW
 Company Mull Drlg.
 Farm Name Harvey C. Pelton No. 1

TOPS	DEPTH	LOG	DATUM
Anh.			
Tp.			
H.			
Tr.			
Dg.			
Bl.			
L.			
K.C.			
B.K.C.			
Ce.			
C.			
M.			
M.			
K.			
Mz.			
Me.			
V.			
S.			
S.			
A.			
R.			
Pe.			
G.			
T.D.			

Loc. in Sec. NW NE SW
 Geol. _____
 Contr. Co. tools
 Pool Wildcat

FIRST REPORT
 APR 25 '56

Date Comm. 4-23-56 Sinc. FO Pure DHM
8" @ 160/150 WOC

0201 S YAM
 R.G.

27

Co.
 Lse.
 No.
 Sec.
 T.
 R.