


Section 29 Township 32 Range 10W

Well No. 1 Goemann

Company Globe O&R

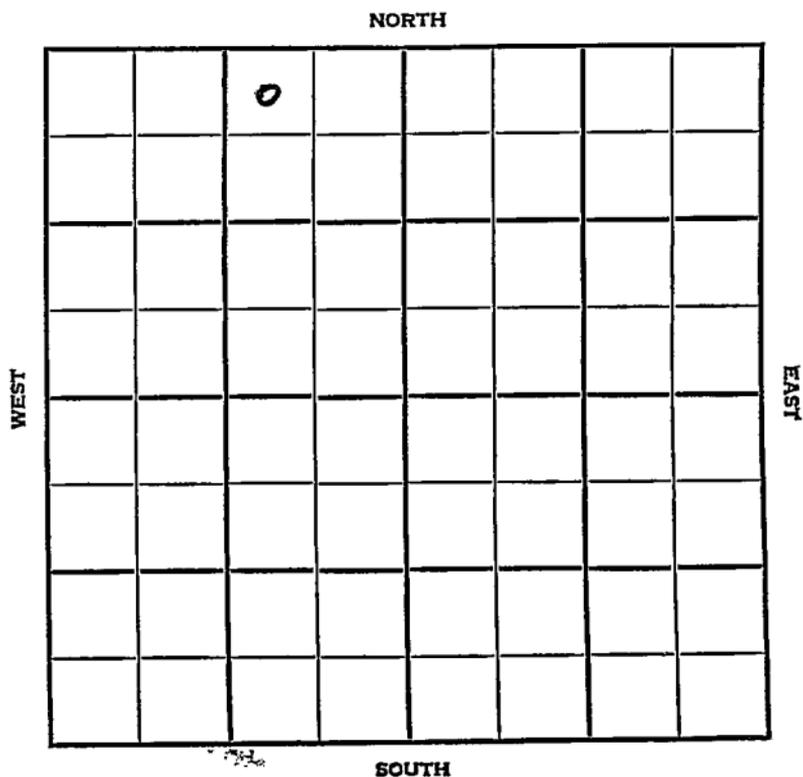

SEC.	TWP.	R.
29	32	10W

WELL NO.

#1 Goemann

FARM

COMPANY

Globe Oil & Ref.

CONTRACTOR

Dudley & Heath

330 Wildcat.
Ft. from N. Line

Ft. from S. Line

990 Ft. from E. Line

Ft. from W. Line

		0							

NORTH

WEST

EAST

SOUTH

NW NE NW

Magnolia F/O Pure - AC & DHM

	ELEVATION	REPORT
1955	1461'	
3/23 6/1	C & P Comm 3-25-55 Elgin 3328, B. Cread 3548, Dg Sd 3587, L 3699, KC 3991, Penn Sd 4381 Miss Ch 4400 Sd TD 4965 LOGS: L 3696, Miss ch 4403, K 4600 V 4692, S 4775, S. Sd 4794, A 4919 8 5/8 @ 280/266, DST 3589-3675, open 1 hr Rec 600' sw 1440/25" DST 3766-85 open 1 hr Rec 180' sw 1490/25" DST 4382-89 open 1 hr Rec 35' gip 25' socm 100/25" DST 4402-15 open 1 1/2 hr Gas in 18 min. Rec 40' gcm 655/25" DST 4413-26 open 1 1/2 hr Rec 1310' gip 30' gcm 880# DST 4427-50 open 1 hr gas in 16 min. Rec 498' muddy gassy oil, 10' muddy wtr. 1440/25", DST 4450-70 open 1 1/2 hr Rec 1000' gip 60' ocm 60' socw 510' wtr. 1510/30" 5 1/2" @ 4504 /100 25/4433-38, 500 A S/33 bf 6 hr S/37 1/2 bf 75% wtr. 5 hr S/24 bf 90% wtr re perf/4433-36 4434 250A S/5 giph frac F/2.7 biph 35% wtr	

1955

6/1 35% wtr F/45.9 bf 34% Wtr. 16 hr
200 MCFG F/44.59 bf 30% wtr
F/36 bf 24 hr (25 bo)
Comp F/16.67 bopd 6.93 bw

COMPLETED

County Barber Elev. 1461
 Sec. 29 Twp. 32 Rge. 10W
 Company Globe Oil & Ref.
 Farm Name Goemann No. 1

TOPS	DEPTH	LOG	DATUM
Anh. <u>Elgin</u>	<u>3328</u>		<u>1867</u>
Exp. <u>B. Oread</u>	<u>3548</u>		<u>2087</u>
H.			
Tr.			
Dg. <u>sw</u>	<u>3587</u>		<u>2126</u>
Bl.			
L.	<u>3699</u>	<u>3696</u>	<u>2235</u>
K.C.	<u>3991</u>		<u>2530</u>
B.K.C.			
Co. <u>Penn sd</u>	<u>4381</u>		<u>2920</u>
C.			
M. <u>ins) Ch</u>	<u>4400</u>	<u>4403</u>	<u>2942</u>
M.			
K.		<u>4600</u>	<u>3139</u>
Mz.			
Mo.			
V.		<u>4692</u>	<u>3231</u>
S.		<u>4775</u>	<u>3314</u>
S. <u>sd</u>		<u>4794</u>	<u>3333</u>
A.		<u>4919</u>	<u>3458</u>
R.			
PE.			
G.			
ED.	<u>4965</u>		

Loc. in Sec. NW NE NW
 Geol. _____
 Contr. Dudley
Heath
 Pool Wildcat

COMPLETE
 MAY 25 1955

Date Comm. 3-25-55
8 5/8" @ 280/266. DST 3589-3675
open 1 hr. Rec. 600' sw I440/25"
DST 3766-85 open 1 hr. Rec. 180' sw
1490/25" DST 4382-89 open 1 hr.
Rec. 35' gip 25' socm 100/25"
DST 4402-15 open 1 1/2 hr. gas in 18 min.
Rec. 40' gcm 655/25# DST 4413-26
open 1 1/2 hr. Rec. 1310' gip 30' gcm
880# DST 4427-50 open 1 hr. gas in

Co.
 Lse.
 No.
 Sec.
 T.
 R.

16 min. Rec. 498' muddy gassy oil
 10' muddy wtr. 1440/25" DST 4450-70
 open 1½ hr. Rec. 1000' gip 60' ocm
 60' socw 510' wtr. 1510/30"
 5½" @ 4504/100 25/ 4433-38 500 A
 S/ 33 bf 6 hr. S/ 37½ bf 75% wtr.
 5 hr. S/ 24 bf 90% wtr. refer/ 4433-
 36 4434 250 A S/ 5 gfph frac
 F/ 2.8 bfph 35% wtr. F/ 45.9 bf
 34% wtr. 16 hr. 200 mcfg F/ 44.59 bf
 30% wtr. F/ 36 bf 24 hr. (25 bo)
 Comp. F/ 16.67 bopd 6.93 bw z

Scout Cards
 Land Small Map
 Land Wall Map
 Tracings
 France Map
 Price Map
 Misc.

JUN 20 1955