


Section 34 Township 32 Range 10 W

Well No. # 2 Pelton

Company Westpan-Hydrocarbon

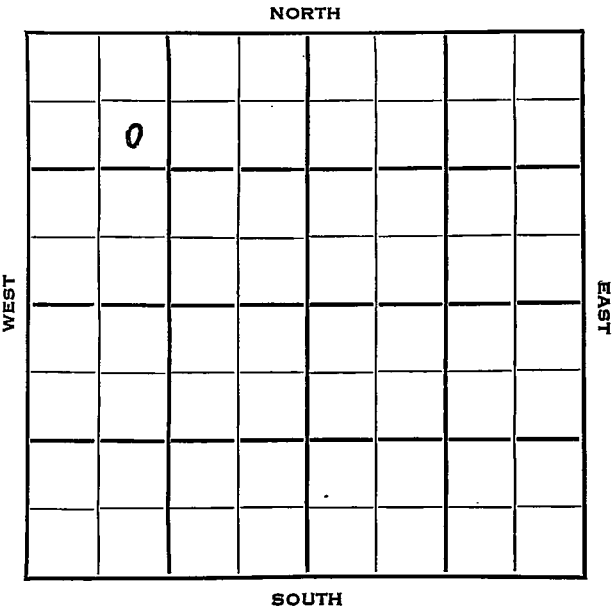

Barber

SEC.	TWP.	R.	KANSAS
34	32		10W ✓

WELL NO.

#2 Pelton

FARM

COMPANY

Westpan-Hydrocarbon

CONTRACTOR

Patton Drlg.

990

Ft. from N. Line


Ft. from S. Line

Ft. from E. Line

990

Ft. from W. Line

SE NW NW

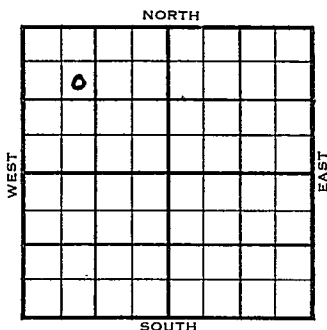

1953

ELEVATION

1450'

REPORT

11/24 Cellar & Pits.

12/9

10" @ 243'

Doug 3484', Lans 3690'

Drlg. 3700'

12/22

Spud 11-29-53

D & A

TD 4740'

10-3/4" @ 243'

Heeb 3452', Doug 3489', Lans 3679'

Miss 4405'

DST 4407'-25' opn 1 hr, rec 15' Mud 150'

DST 4425'-47' gas in 45 min, rec 180'

gas, 176' gcm 1300#

DST 4425'-47' opn 3 hr, rec gas in 1 hr

42 min rec 176' gcm w/ spots of oil

180' oily mud 180' wtr 1110#

TD 4740'

D & A

ABANDONED

County Barber State Kansas
 Sec. 34 (Blk.) 32 (Sur.) 10W Map No.
 Operator Westpan-Hydrocarbon
 Well No. 2 Farm Polton
 Elev. _____ Location SE NW NW

	0						

FIRST REPORT

990 Ft. From N Line NW
990 Ft. From W Line Quarter
 1st. Report NOV 24 1953

Completion _____

Remarks _____


Spudding Date _____

Drig. Data _____

Cellar & pits

J. G. McGEHEE

County Barber State Kansas
 Sec. 34 (Blk.) 32 (Sur.) 10W Map No.
 Operator Westpan-Hydrocarbon
 Well No. 2 Farm Pelton
 Elev. 1450 Location SE NW NW

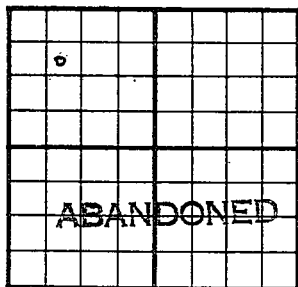

990 Ft. From N Line NW
990 Ft. From W Line Quarter

1st. Report

Completion DEC 22 1953

Remarks

Patton Drlg. - Contr.

Spudding Date 11-29-53

Drlg. Data D & A TD 4740

10 3/4" @ 243 Heeb. 3452 Doug. 3489

Lans. 3679 Miss. 4405 DST 4407-25

open 1 hr. Rec. 15' mud 150#

DST 4425-47 gas in 45 min. Rec. 180' gas

176' gcm 1300# DST 4425-47 open 3 hr.

gas in 1 hr. 42 min. Rec. 176' gcm w/

spots of oil 180' oily mud 180' wtr.

1110# TD 4740

D & A

J. G. McGEHEE