


Section 3 Township 32S Range 10W

Well No. #1 Amsden

Company Sinclair Oil & Gas

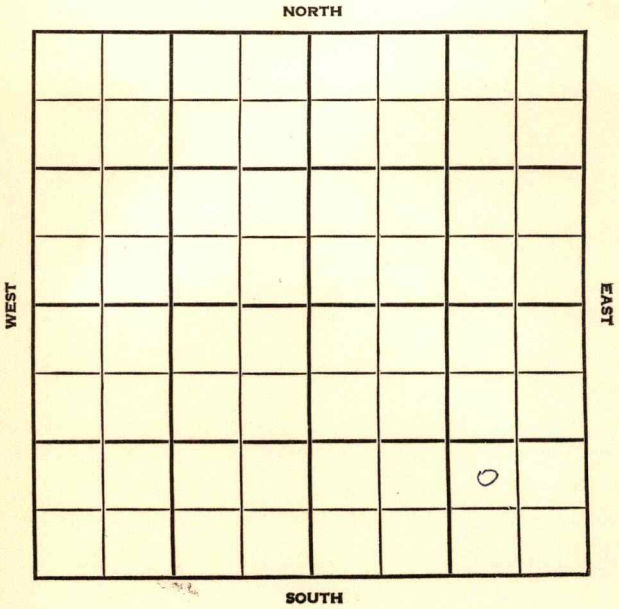


SEC. 3	TWP. 32	R. 10W
-----------	------------	-----------

WELL NO. #1 Amsden FARM

COMPANY Sinclair Oil & Gas

CONTRACTOR

_____ FT. FROM N. LINE
 _____ FT. FROM S. LINE
 _____ FT. FROM E. LINE
 _____ FT. FROM W. LINE

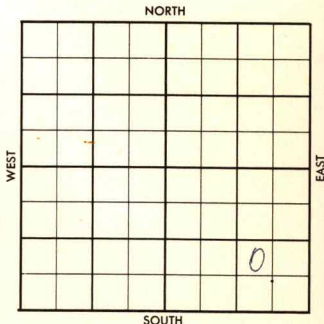

NW SE SE

1956	ELEVATION	REPORT
------	-----------	--------

7-25 Loc.

County Barber Elev. 1526
 Sec. 3 Twp. 32S Rgs. LOW
 Company Sinclair Oil & Gas
 Farm Name Amsden No. 1

Co.

TOPS	DEPTH	LOG	DATUM
Anh.			
TP.	3166		
H.	3500	3529	
Tr.			
Dg.	3563	3568	
BL.			
L.	3672	3678	
K.C.			
B.K.C.		4158	
Ce.			
C.			
M.	4352	4351	
M.			
K.			
Mz.			
Mo.			
V.			
S.			
S.			
A.			
R.			
PE.			
G.			
TD.	4525		

Loc. in Sec. NW SE SE
 Geol. _____
 Contr. Barboor

Loc.

SEP 19 '56
 SEP 20 '56
COMPLETE

No.

Date Comm. Loc. AUG 1 '56 MIRT
AUG 8 '56 8 - 2 - 56 10 3/4 325
1205 AUG 15 '56 DST 3625
AUG 22 '56 DST 3614 - 25 45"
see 6' Md 1285/20"
crd 4350-70 Full rec. DST
4353-70 3 hrs G/1 3/2" ga
277 MCF/5" Max ga 537 MCF
13 hrs see 90' GCM SW 1445/30"
CRG AUG 29 '56 crd 4370 - 90 see

Sec.

T.

R.

20' crd 4390-4403 rec 13'
 DST 4369-90 2 1/2 hrs G/6"
 stab @ 815 MCF rec 60' GCM SW
 1445/30" FP 35-65 DST
 4389-4403 2 hrs G/3" stab
 @ 499 MCF rec 60' MSW FP
 45-65 BHP 1450/30" crd
 4403-15 1/2 Full rec DST
 4401-15 1/2 op. 105" G/5 1/2"
 99 98 MCF/30" stab 1 @
 139 MCF/45" rec 30' 56 C. oily
 Md + 90' G 8' 0 CSW + 90' SW
 FP 25-115 BHP 1582/30"
 5 1/2 @ 4525/225 ^{SEP 5 '56} CO 4461
 112/4401-29 1/2 Flwd by heads
 Flw 2 Boph + est 100 MCF G
 SQD PF 4401-29 80/4359-79
 Frac Flg Ld + est 2,800 MCF G
^{SEP 12 '56} Flg Ld + 2,570 MCF
 + 2.7 Bwph 3 hr test
 TP 90 S. I. ^{SEP 19 '56} cal op Flw
 3,893 MCF + 3 1/2 Bwph
 (mostly wtr - SIP 1245#

County Barber Elev. _____
 Sec. 3 Twp. 32S Rge. 10W
 Company Sinclair Oil & Gas
 Farm Name Amsden No. 1

TOPS	DEPTH	LOG	DATUM
Anb.			
Tr.			
H.			
Tr.			
Dg.			
B.L.			
L.			
K.C.			
B.K.C.			
Ce.			
C.			
M.			
M.			
K.			
Mz.			
Mq.			
V.			
S.			
S.			
A.			
R.			
Pe.			
G.			
T.D.			

Loc. in Sec. NW SE SE
 Geol. _____
 Contr. _____
 Pool _____

JUL 25 1956
 FIRST REPORT

Date Comm. _____ Loc. _____

257

AUG 1 1956

R. G.

Co.
Lse.
No.
Sec.
T.
R.