


Section 6 Township 32 Range 10W

Well No. 1 Dick "A"

Company G-M-R & Aurora et al

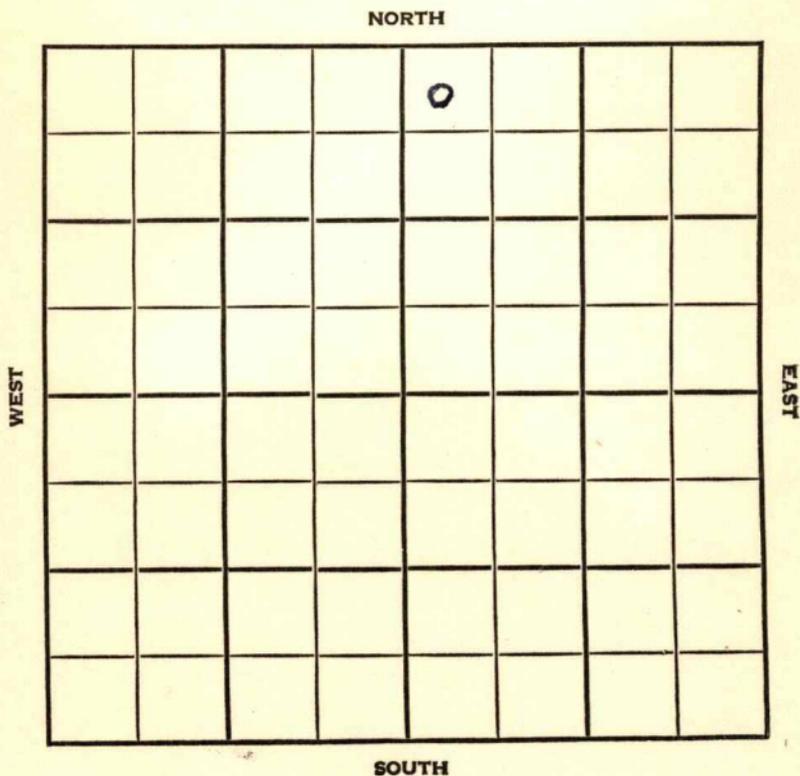

Barber

SEC. 6	TWP. 32	R. KANSAS 10W
--------	---------	-------------------------

WELL NO. #1 Dick "A" FARM

COMPANY G-M-R & Aurora et al

CONTRACTOR Co. Tools.

Wildcat.

330	Ft. from N. Line	<table border="1"> <tr><td></td><td></td><td></td><td></td><td>0</td><td></td><td></td></tr> <tr><td></td><td></td><td></td><td></td><td></td><td></td><td></td></tr> <tr><td></td><td></td><td></td><td></td><td></td><td></td><td></td></tr> <tr><td></td><td></td><td></td><td></td><td></td><td></td><td></td></tr> <tr><td></td><td></td><td></td><td></td><td></td><td></td><td></td></tr> <tr><td></td><td></td><td></td><td></td><td></td><td></td><td></td></tr> <tr><td></td><td></td><td></td><td></td><td></td><td></td><td></td></tr> <tr><td></td><td></td><td></td><td></td><td></td><td></td><td></td></tr> </table>					0	
					0	
	Ft. from S. Line	
	Ft. from E. Line	
330	Ft. from W. Line	

NW NW NE Stanolind, Magnolia & Aylward - DHM

1955	ELEVATION	REPORT
	1625'	

1/19 Spud 1-15-55
8" @ 233'
Drlg. 1882'

2/23 spud 1-15-55 D & A TD 4932
8" @ 233' **Lans 3786**
DST 3749-85 open 1 hr rec 800' SW
1275#
DST 3 678-3705 open 35 min rec 9' mud
120# **Miss 4431**
DST 4427-45 open 1 hr rec 185' VSO &
GCM 450#
DST 4446-65 open 1 hr rec 250' 0 &
GCM, 690' 0 & GCSW 1840#
DST 4583-4610 open 1 hr rec 35' mud 0#
Kh. 4615' Chattanooga 4663' Viola 471'
Simp. sh. 4777', Simp. sd. 4778'
Arb. 4907'
TD 4932 5" @ 4490
LOG TOPS: **Lans 3784 Miss 4430**
Kh. 4615' Viola 4716 Simp. 4775'
Arb. 4901' Co to 4460 20/4432-37
sd-oil-frac S/25 BWPB VSSO
100,000 CFG D & A

ABANDONED

County Barber State Kansas

Sec. 6 (Blk. Twp.) 32 (Sur. Rge.) 10W Map No.

Operator G-M-R & Aurora etal.

Well No. 1 Farm Dick "A"

Elev. _____ Location NW NW NE



330 Ft. From N Line NE

330 Ft. From W Line Quarter

Ist. Report JAN 1 9 1955

Completion _____

Remarks Stanolind, Magnolia & Aylward - DFM

Co. tools

Spudding Date 1-15-55

Drlg. Data Wildcat

8" @ 233 drlg. 1882

FADEN GLESTRAP

County Barber State Kansas

Sec. 6 (Blk. 32) (Sur. Rge.) 10W Map No.

Operator G-M-R & Aurora etal.

Well No. 1 Farm Dick "A"

Elev. 1625 Location NW NW NE



330 Ft. From N Line NE

330 Ft. From W Line Quarter

1st. Report

Completion FEB 23 1955

Remarks Wildcat

Co. tools

Spudding Date 1-15-55

Drlg. Data D & A TD 4932

8" @ 233 Lans. 3786 DST 3749-85

open 1 hr. Rec. 800' sw 1275#

DST 3678-3705 open 35 min. Rec. 9' mud

120# Miss. 4431 DST 4427-45 open 1 hr

Rec. 185' vso & gcm 450# DST 4446-65

open 1 hr. Rec. 250' o & gcm 690' o &

gcsw 1840# DST 4583-4610 open 1 hr.

Rec. 35' mud 0# Kh. 4615

Chattanooga 4663 Viola 4717

Simp. sh. 4777 Simp. sd. 4778 Arb. 4907

TD 4932 5" @ 4490 LOG TOPS?

Lans. 3784 Miss. 4430 Kh. 4615

Viola 4716 Simp. 4775 Arb. 4901

CO to 4460 20/ 4432-37 sd-oil-frac

OVER

FABEN GILSTRAP

OAE

Drlg. Data

S/ 25 bwph VSSO 100,000 cfg

D & A

_____	Misc.
_____	Pierce Map
_____	France Map
_____	Tracings
_____	Land Wall Map
_____	Land Small Map
_____	Scout Cards

[Handwritten signature]

MAR 2 1955