


Barber

KANSAS

SECTION 1 TOWNSHIP 32 S RANGE 10 W

WELL NO. # 1 Richardson

COMPANY Aylward Drlg. Co.

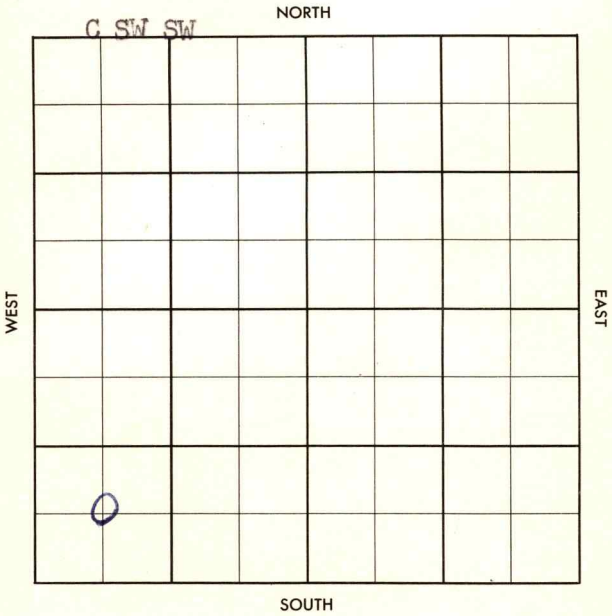

County Barber Elev. _____
 Sec. 1 Twp. 32S Rge. 10W
 Company Aylward Drlg. Co.
 Farm Name Richardson No. 1

TOPS	DEPTH	LOG	DATUM	Loc. in Sec. _____
Anh.				<u>C SW SW</u>
TP.				
H.				
Tr.				
Dg.				
BL.				
L.				Geol. _____
K.C.				Contr. _____
B.K.C.				<u>Co. righ #3</u>
Ce.				
C.				Pool _____
M.				<u>Sharon NW</u>
M.				
K.				
Mz.				
Me.				
V.				
S.				
S.				
A.				
R.				
Pe.				
G.				
T.D.				

FIRST REPORT
 AUG 21 1957

Date Comm. Mag. - FO

Loc. _____

~~27~~

County Barber Elev. 1510 DF
 Sec. 1 Twp. 32S Rgs. 10W
 Company Aylward Drlg. Co.
 FarmName Richardson No. 1

TOPS	DEPTH	LOG	DATUM
Anh.	1340		
Tr.			
H.	3482		
Tr.			
Dg.			
Bl. <u>B o mad</u>	3532		
L. <u>D 9 sd</u>	3601		
<u>HE L</u>	3660		
B.K.C.			
Ce. <u>sd</u>	4351		
C.			
M.	4363		
M. <u>chert</u>	4399		
K.			
Mz.			
Mo.			
V.			
S.			
S.			
A.			
R.			
PE.			
G.			
T.D.	4419		

Loc. in Sec. C SW SW
 Geol. _____
 Contr. _____
 Co. right #3
 Pool
 Sharon NW

ABANDONED
 SEP 11 57
 0

Date Comm. Mag. - FO

Loc. AUG 28 57 SPD 8-23-57 858
191/150 2206 SEP 4 57 2900
SEP 11 57 DST 4348-61 40" 10' MD
FP 30-30 BHP 40/30" FRHT
30/30"

DLA

Co.
 No.
 Sec.
 T.
 R.