

Barber

KANSAS

2

32

10W

SECTION _____ TOWNSHIP _____ RANGE _____

#1 McDaniel


WELL NO. _____

COMPANY Gulf

NORTH

WEST

EAST

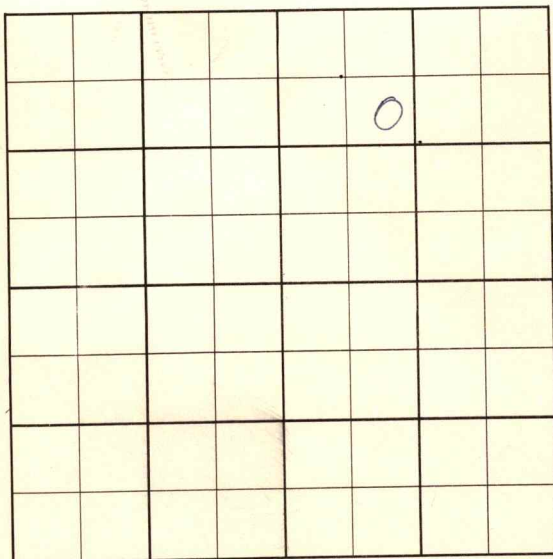

SOUTH

County Barber Elev. 1564
 Sec. 2 Twp. 32 Rge. LOW
 Company Gulf
 Farm Name McDaniel No. 1

TOPS	DEPTH	LOG	DATUM	Loc. in Sec.
Anh.				
Tp.				<i>See map re</i>
H.	3458	3		
Tr.				
Dg. <i>sd</i>	3690	3629		
Bl.				
L.	3713	3720		
K.C.				Geol.
B.K.C.				Contr.
Ce.				
C.				
M. <i>chert</i>	4381	4389		
M. <i>bl</i>		4497		Pool
K.				
Mz.				
Mq.				
V.				
S.				
S.				
A.				
R.				
Pe.				
G.				
T.D.	4560			

COMPLETE
 NOV 23 '56

Date Comm.

Location OCT 17 '56 10-12-56 858288/225 1925 OCT 24 '5610 3910 OCT 31 '56 DST 4381-4455or 34" G 1/2" ga 2.600 MCF 1/4"ga 3.310 MCF 1/9" rec 210 505 H GCM EP 430-475 BHP 1635130" 4 1/2 4558/125 NOV 7 '56 PB4531 24/4404-10 120/4420-5011 Frac Plug Ld + 4.30 MCF GCP 650 5.1. NOV 13 '56 F/9 Ld. + 3.700 MCF

Cal on F/W 7,400 MCFG
(Bureau of Mines)

County Barber Elev. _____
 Sec. 2 Twp. 32 Rge. 10W
 Company Gulf
 Farm Name McDaniel No. 1

TOPS	DEPTH	LOG	DATUM	Loc. in Sec.
Anh.				<u>See NW NE</u>
Tr.				
Dg.				
Bl.				
L.				Geol.
K.C.				Contr.
B.K.C.				
Ce.				
C.				
M.				Pool
M.				
K.				
Mz.				
Me.				
V.				
S.				
S.				
A.				
R.				
Pe.				
G.				
T.D.				

FIRST REPORT

Date Comm.

Location OCT 10 '36

OCT 10 '36

OCT 10 '36