


SECTION 3 TOWNSHIP 32S RANGE 10W

WELL NO. #1 Hanna O'Neil

COMPANY Amerada

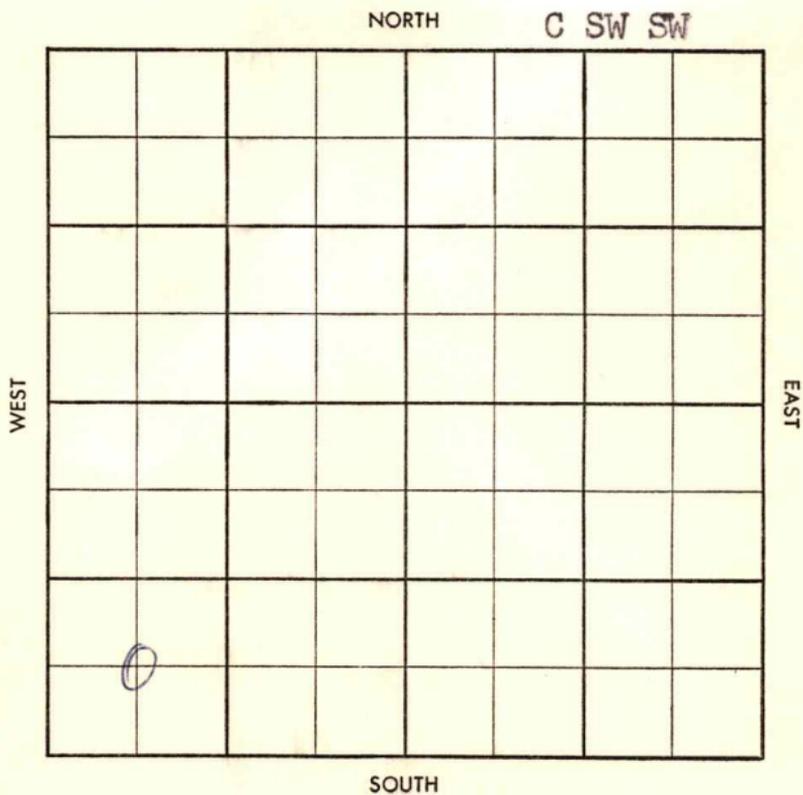

27

County Barber Elev. _____
 Sec. 3 Twp. 32 Rge. LOW
 Company Amerada
 Farm Name Hanna O'Neil No. 1

TOPS	DEPTH	LOG	DATUM
Anh.			
Tp.			
H.			
Tr.			
Dg.			
B.L.			
L.			
K.C.			
B.K.C.			
Ce.			
C.			
M.			
M.			
K.			
Mz.			
Mq.			
V.			
S.			
S.			
A.			
R.			
Pf.			
G.			
T.D.			

Loc. in Sec. _____

C SW SW


Geol. _____

Contr. _____

Barbour Drlg

Pool _____

Sheridan NW

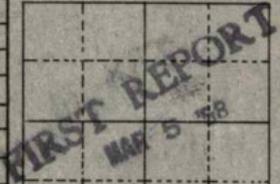		
		0

Date Comm. _____

Location

Co.
 Lse.
 No.
 Sec.
 T.
 R.

~~Barber~~ ~~Pool~~
~~Barber~~ ~~Pool~~

County Barber Elev. 15250-152800
 Sec. 3 Twp. 32 Rge. 10W
 Company Amerada
 Farm Name Hanna O'Neil No. 1

TOPS	DEPTH	LOG	DATUM
Anh.	4		
Tp.			
H.	3517		
Tr.			
Dg.	3582		
B.L.			
L.	3692		
K.C.			
B.K.C.			
Ce.			
C.			
M.	4359		
M.			
K.			
Mz.			
Mq.			
V.			
S.			
S.			
A.			
R.			
Pf.			
G.			
T.D.	4438		

Loc. in Sec. C SW SW
 Geol. _____
 Contr. _____
Barbour Drlg
 Pool Sheridan NW

COMPLETE
 APR 16 '58

Date Comm. 3-6-58 8"267/225

Location Ø1660 MAR 12 '58 Ø197 MAR 26 '58

DST 4366-940p
2 hrs g 1/4" ga 528 met rec
210' Regum FP 135-105 BHPM20
-1440 DST 4409-380p/1hr rec
10' MNS FP 25-40 BHP 55/30"
log 5 1/2 4437 MICT APR 2 '58
32 1/2 4356-74 (A) F10 196 met
FCP 50 NW frac 20 x 18
ga 1.630 met 40/64 chlk

Co.
 No.
 Sec.
 T.
 R.

End 12hr tst Fl 2. 310 mcf
 40/64" chkr FTP 475 FCP 775
 SICP 1400 SITP 1375 APR 9 '58
 Deliverability tst ga 2.420
 mcf now 3 hrs 30/64" chkr
 FCP 1095 FTP 1110 SICP
 1473 SITP 1473 APR 16 '58 Ca op Fl
 2.700 mcf +2BAW FCD
 1149 FTP 1000 SICP
 1486 ~~1486~~ SITP 1486 15/64" chkr