



Inde

STATE CORPORATION COMMISSION OF KANSAS
OIL & GAS CONSERVATION DIVISION

WELL COMPLETION OR RECOMPLETION FORM
ACO-1 WELL HISTORY

DESCRIPTION OF WELL AND LEASE

Operator: License # 5509
Name Sun West Exploration
Address 9785 S. Merriam Circle
Suite 310
City/State/Zip Englewood Colo. 80116

Purchaser NONE

Operator Contact Person Robert Ferro Jr.
Phone 303-790-2177

Contractor: License # 5418
Name Allen Drilling

Wellsite Geologist Ernest R. Morrison
Phone 303-7311

Designate Type of Completion
 New Well Re-Entry Workover
 Oil SWD Temp Abd
 Gas Inj Delayed Comp.
 Dry Other (Core, Water Supply etc.)

If OWWO: old well info as follows:
Operator
Well Name
Comp. Date Old Total Depth.....

WELL HISTORY

Drilling Method:
 Mud Rotary Air Rotary Cable
5-30-85 6-2-85 6-2-85
Spud Date Date Reached TD Completion Date
2830' 2844'
Total Depth PBT

Amount of Surface Pipe Set and Cemented at 326 feet
Multiple Stage Cementing Collar Used? Yes No
If yes, show depth set.....feet
If alternate 2 completion, cement circulated
from.....feet depth to.....w/.....SX cmt

API NO. 15-007-22-040
County Barber
C. W. E. Sec 26 Twp 32 Rge 11 East West

3300 Ft North from Southeast Corner of Section
290 Ft West from Southeast Corner of Section
(Note: Locate well in section plat below)


Lease Name Adrian Van Zandt Well #.....

Field Name Rhodes

Producing Formation None

Elevation: Ground 1491' KB 1496'

Section Plat

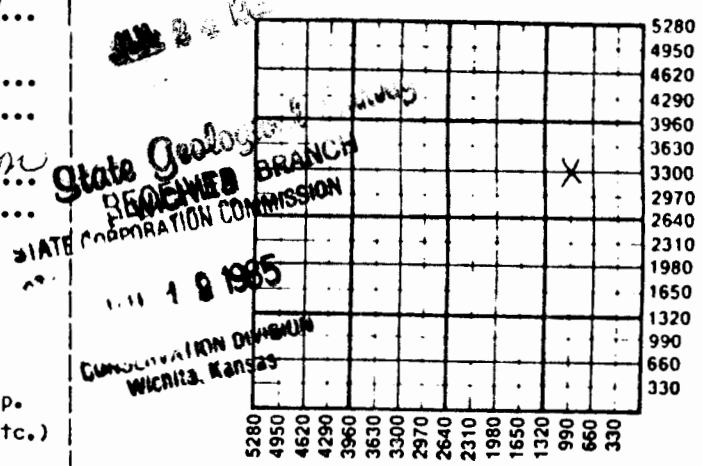

WATER SUPPLY INFORMATION

Disposition of Produced Water: Disposal Repressuring
Docket #

Questions on this portion of the ACO-1 call:
Water Resources Board (913) 296-3717

Source of Water:
Division of Water Resources Permit # T-85-512

Groundwater 330 Ft North from Southeast Corner
(Well) 290 Ft West from Southeast Corner of
Sec 26 Twp 32 Rge 11 East West

Surface Water.....Ft North from Southeast Corner
(Stream, pond etc).....Ft West from Southeast Corner
Sec Twp Rge East West

Other (explain).....
(purchased from city, R.W.D. #)

INSTRUCTIONS: This form shall be completed in duplicate and filed with the Kansas Corporation Commission, 200 Colorado Derby Building, Wichita, Kansas 67202, within 90 days after completion or recompletion of any well. Rule 82-3-130 and 82-3-107 apply.

Information on side two of this form will be held confidential for a period of 12 months if requested in writing and submitted with the form. See rule 82-3-107 for confidentiality in excess of 12 months. One copy of all wireline logs and drillers time log shall be attached with this form. Submit CP-4 form with all plugged wells. Submit CP-111 form with all temporarily abandoned wells.

26-32-11W

SIDE TWO

Operator Name Sea West Exploration Lease Name Adrian Van Zandtberg Well # 2

Sec. 26 Twp. 32S Rge. 11 East West County Barber

WELL LOG

INSTRUCTIONS: Show important tops and base of formations penetrated. Detail all cores. Report all drill stem tests giving interval tested, time tool open and closed, flowing and shut-in pressures, whether shut-in pressure reached static level, hydrostatic pressures, bottom hole temperature, fluid recovery, and flow rates if gas to surface during test. Attach extra sheet if more space is needed. Attach copy of log.

Drill Stem Tests Taken Yes No
Samples Sent to Geological Survey Yes No
Cores Taken Yes No

Formation Description
 Log Sample

Name	Top	Bottom
Indian Cave	2559	(-1063)
Wabaunsee	2604	(-1108)
Tarkio Sandstone	2792	(-1296)
Total Depth	2844	(-1346)

JUL 24 1955

State Geological Survey
MICHITA BRANCH

CASING RECORD <input checked="" type="checkbox"/> New <input type="checkbox"/> Used							
Report all strings set-conductor, surface, intermediate, production, etc.							
Purpose of String	Size Hole Drilled	Size Casing Set (In O.D.)	Weight Lbs/Ft.	Setting Depth	Type of Cement	#Sacks Used	Type and Percent Additives
surface	12 1/4"	8 5/8"	23 #	326'	60-40	250 sk	2% gal, 3% cc
PERFORATION RECORD				Acid, Fracture, Shot, Cement Squeeze Record			
Shots Per Foot	Specify Footage of Each Interval Perforated			(Amount and Kind of Material Used)			Depth
	NONE						
TUBING RECORD				Liner Run <input type="checkbox"/> Yes <input type="checkbox"/> No			
	Size	Set At	Packer at				
		NONE					
Date of First Production		Producing Method					
		<input type="checkbox"/> Flowing <input type="checkbox"/> Pumping <input type="checkbox"/> Gas Lift <input type="checkbox"/> Other (explain).....					