


DX 78-1

Barber

Section 10 Township 32 Range 11W
 Well No. #1 Groendycke
 Company Sinclair O&G

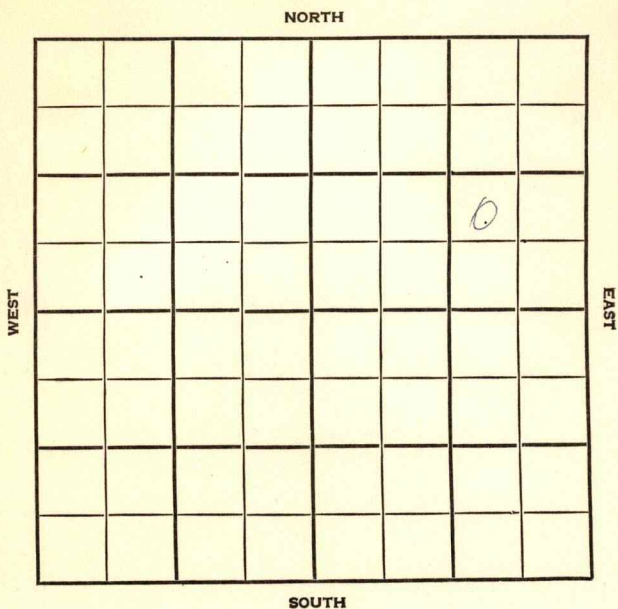

County Barber Elev. _____
 Sec. 10 Twp. 32 Rge. 11W
 Company Sinclair O & G
 Farm Name Groendycke No. 1

TOPS	DEPTH	LOG	DATUM	Loc. in Sec.
Anh.				NW SE NE
Tp.				
H.				
Tr.				
Dg.				
Bl.				
L.				Geol.
K.C.				Contr.
B.K.C.				<u>Barbour</u>
Ce.				Pool
C.				
M.				
M.				
K.				
Mz.				
Me.				
V.				
S.				
S.				
A.				
R.				
Pe.				
G.				
T.D.				

FIRST REPORT
 JAN 9 '57

Date Comm. 1-4-57

10" @ 270/200 drlg. 2055

26

Co.

County Barber Elev. 1541
 Sec. 10 Twp. 32 Rg. 11W
 Company Sinclair O & G
 Farm Name Groendycke No. 1

TOPS	DEPTH	LOG	DATUM	Loc. in Sec.
Anh.				NW SE NE
Tr.				
H.	3589			
Tr. Snyderville	3600-21			
Dg. Tr	3646	3646		
Bl. Dg	3679	3678		
L.	3751	3752		
K.C.				Geol.
B.K.C.	4216	4212		
Ce. sd	4394	4390		Contr.
C. MISS LI	4409			Barbour
M.	4491			
M. chert	4491	4491		Pool
K.		4523		
Mz.				
Mo.				
V.				
S.				
S.				
A.				
R.				
PE.				
G.				
TD.	4598			ABANDONED

Sec.

No.

Sec.

T.

R.

Date Comm. 1-4-57

10" @ 270/200 drlg. 2055

JAN 10 '57

DST 3600-09 1hr 7' Md

FP 0-0 BHP 1195/30 3821

JAN 23 '57 CRD 4396-4404 rec 1'6"

DST 4392-4404 1hr 15' Md

FP BHP 32/30" DST 4408-27

1hr 14' Md BHP 1040/30" JAN 30 '57

CRD 4427-44 Full rec DST 4491

- 4507 1hr 20' Md BHP 1155

B.F.R.