


Section 11 Township 32 Range 11W
Well No. #1 Schiff "B"
Company Byard Bennett (K.C., Mo.)

NORTH

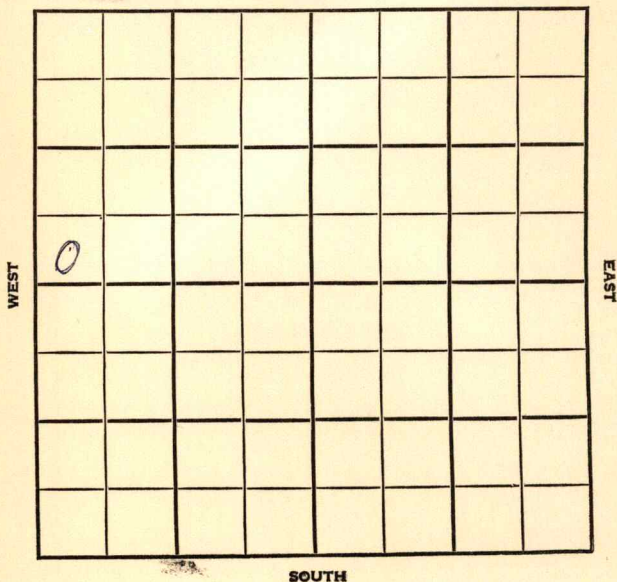

County BarberElev. 1538Sec. 11 Twp. 32 Rge. 11WCompany Byard Bennett (K.C. Mo.)Farm Name Schiff "B" No. 1

TOPS	DEPTH	LOG	DATUM	Loc. in Sec.
Anh.				SW SW NW
TP.				
H.	3592			
Tr.				
Dg.	3610			
BL.				
L.	3772			Geol.
K.C.				Contr.
B.K.C.	4244			Jones, Shelburn
Ce. <u>sd</u>	4402			Farmer Tools
C.				Pool
M.	4408			<u>Highway N.</u>
M.				<u>Wildcat</u>
K.				
Mz.				
Mq.				
V.				
S.				
S.				
A.				
R.				
PE.				
G.				
TD.	4450			

ABANDONED

APR 10 '57

Date Comm. Spd. 11-15-56

Gulf (FO) NOV 21 '56

NOV 28 '56

DEC 5 '56

C&P

DEC 12 '56

12-6-56 898 238/175 @ 2430

DEC 19 '56

11 36 DST 3600-30 1hr

rec 785' MSW FP 110-490

BHP 1300/20 @ 4190

DEC 26 '56

DST 4400-41 @ 7 hrs 15 in 45 sec.

no ga. rec. 3' oil + 332' SW BHP

1710 5 1/2 4449 WOCT JAN 2 '57 JAN 9 '57

~~112/4403-31~~ 112/4403-31 +5T ~~112/4403-31~~
 2 1/2 Mill CEG 1/2 Flwd
 2 1/2 Mill CEG JAN 10 '57 CO ~~RE~~
~~screened out~~ Frac 15 X 15
 screened out CO REFF. 4403-31
 Frac \$ 9 BWph \$
 24 BWph S.D. JAN 23 '57 JAN 30 '57
 FEB 6 '57 FEB 13 '57 FEB 20 '57 FEB 27 '57 MAR 6 '57
 MAR 13 '57 MAR 20 '57 MICT CO MAR 27 '57
 APR 3 '57 APR 10 '57 pulled pipe

D & A

WILDCAT

FORM 513 SUNRAY

County Barber Elev. _____
 Sec. 11 Twp. 32 Rge. 11W
 Company Byard Bennett (K.C. Mo.)
 FarmName Schiff No. 1

TOPS	DEPTH	LOG	DATUM	Loc. in Sec.
Anh.				SW SW NW
Tp.				
H.				
Tr.				
Dg.				
Bl.				
L.				
K.C.				Geol. _____
B.K.C.				Contr. _____
Ce.				Jones, Shelburne
C.				Farmer Tools
M.				Pool
M.				Wildcat
K.				
Mz.				
Me.				
V.				
S.				
S.				
A.				
R.				
Pe.				
G.				
T.D.				

FIRST REPORT

Date Comm. Spd. 11-15-56

Gulf (FO)

APPROVED BY

[Handwritten signature]

10-51