

Barber


**KANSAS**

SECTION 13 TOWNSHIP 32 RANGE 11W

WELL NO. #1 McGuire

COMPANY Musgrove Petr.

NORTH

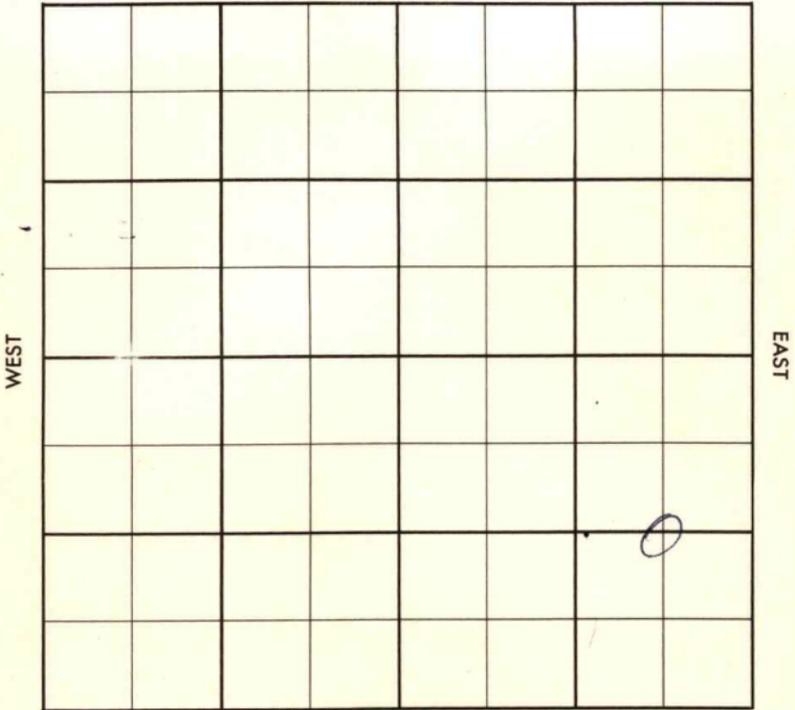

SOUTH

County Barber Elev. \_\_\_\_\_  
 Sec. 13 Twp. 32 Rge. 11W  
 Company Musgrove Pet.  
 Farm Name McGuire No. 1

TOPS	DEPTH	LOG	DATUM
Anb.			
TP.			
H.			
Tr.			
Dg.			
Bl.			
L.			
K.C.			
B.K.C.			
Ce.			
C.			
M.			
M.			
K.			
Mz.			
Ma.			
V.			
S.			
S.			
A.			
R.			
PE.			
G.			
TR.			

Loc. in Sec. C E  $\frac{1}{2}$  SE  
 Geol. \_\_\_\_\_  
 Contr. Lewis Drlg.  
 Pool \_\_\_\_\_

FIRST REPORT  
 DEC 12 1958

Date Comm. MIR

~~26~~

Co.  
 Use.  
 No.  
 Sec.  
 T.  
 R.

County Barber Elev 51502 DF  
 Sec. 13 Twp. 32 Rge. 11W  
 Company Musgrove Pet.  
 Farm Name McGuire No. 1

TOPS	DEPTH	LOG	DATUM
Anh.			
Tr.			
H.	3545	3544	
Tr.			
Dg.	3664	3611	
BT <u>Dg sd</u>		3663	
L.	3727	3727	
K.C.			
B.K.C.			
Co. <u>Pennsd</u>		4385	
G. <u>B.R. c9</u>		4400	
M. <u>erro.</u>		4413	
M. <u>chert</u>		4422	
K. <u>M.L.</u>		4425	
Mz.			
Mo.			
V.			
S.			
S.			
A.			
R.			
PE.			
G.			
T.D.	4500		

Loc. in Sec. C E  $\frac{1}{2}$  SE  
 Geol. \_\_\_\_\_  
 Contr. Lewis Drlg.  
 Pool \_\_\_\_\_

FEB 6 '57  
**COMPLETE**

Date Comm. MIR DEC 19 '56 12-11-56 8578  
197/200  $\emptyset$  3385 DEC 26 '56  $\emptyset$  4380  
JAN 2 '57 DST 4415-48 OR 75"  
G/8" ga 702 MCF /65" new  
85' GCM + 100' GSSY WM + 30'  
9554 WT FP 100-220 BHT  
1625/200 5 1/2 4499/150  
JAN 3 '57  $\checkmark$  WACT JAN 23 '57  
CO 4485 to PF JAN 30 '57 24/4412

- 20 1st 1 B0 1W 6/4420

- 22 no inc. ~~1/2~~ no inc

30/4420-26 \$ 556 FRAC

Fld ga 2.810 MCFG w/ no fluid

S.L. FEB 6 '57 CSO Calc. of Flow

complete

ga 2.10 MCFG PD