
Barber KANSAS

SECTION 13 TOWNSHIP 32 RANGE 11W

WELL NO. #1 George McGuire

COMPANY Gulf Oil & Pan American

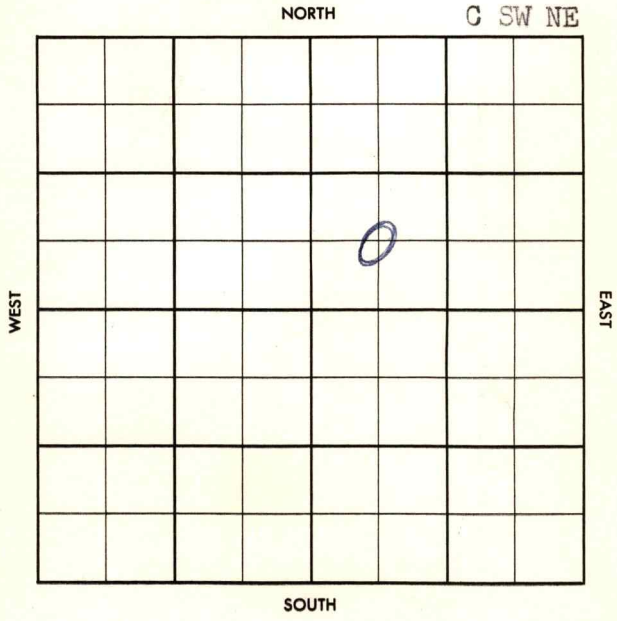

FORM 504-3 SUNRAY

FORM 513 SUNRAY

County Barber Elev. Co.

Sec. 13 Twp. 32 Rge. 11W

Company Gulf Oil & Pan American

Farm Name George McGuire No. 1

TOPS	DEPTH	LOG	DATUM
Anh.			
Tp.			
H.			
Tr.			
Dg.			
Bl.			
L.			
K.C.			
B.K.C.			
Ce.			
C.			
M.			
M.			
K.			
Mz.			
Mc.			
V.			
S.			
S.			
A			
R.			
P€.			
G.			
T.D.			

Loc. in Sec. C SW NE

4600' Miss Tes

Geol.

Contr. Lse.

Pool McGuire-Goeman

FIRST REPORT

O

JUL 3 '57 No.

Date Comm.

Location Sec.

T.

R.

26

FORM 513 SUNRAY

County Barber Elev. 1568

Sec. 13 Twp. 32 Rge. 11W

Company Gulf Oil & Pan American

Farm Name George McGuire No. 1

TOPS	DEPTH	LOG	DATUM
Anh.			
T.P.			
H.	3603		
Tr.			
Dg. Sh.	3672		
Bl. Dg sd	3722	3717	
L.		3781	
K.C.			
B.K.C. Marm.		4258	
Ce.			
C.			
M. chert	4462	4462	
M. LI	4493	4510	
K.			
Mz.			
Mo.			
V.			
S.			
S.			
A			
R.			
P€.			
G.			
T.D.	4573		

Loc. in Sec. C SW NE

4600' Miss Tes

Geol.

Contr.

Pool McGuire-Goeman

ABANDONED

O

JUL 24 '57

Date Comm.

Location JUL 10 '57 7-8-57. 8 5/8

293/250 ℔ 1800 JUL 17 '57

℔ 4457 JUL 24 '57 DST 4464-98

thn rec 49' ℔ Md no show

BHP 802/30

D&A

Co. Lse. No. Sec. T. R.