


Section 22 Township 32 Range 11W  
Well No. #1 Gilbert  
Company Musgrove Petr.

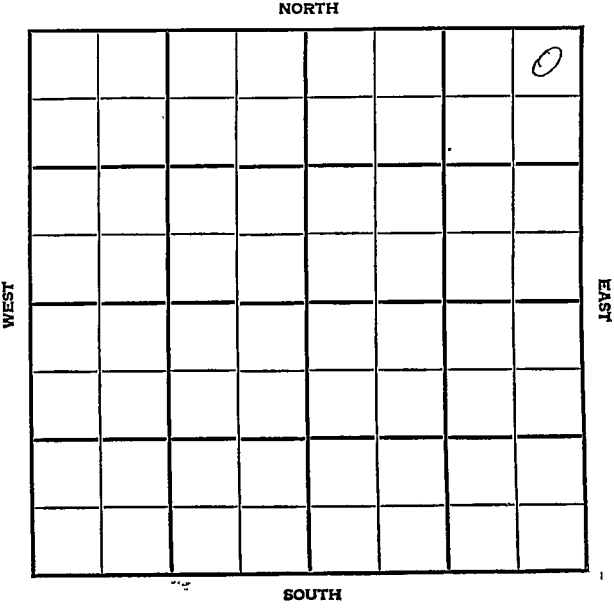

County Barber Elev. 1508 DF  
 Sec. 22 Twp. 32 Rgs. 11W  
 Company Musgrove Pet.  
 Farm Name Gilbert No. 1

| TOPS            | DEPTH | LOG | DATUM |
|-----------------|-------|-----|-------|
| Anb.            |       |     |       |
| TP.             |       |     |       |
| H.              | 3564  |     |       |
| Tr. <u>3d</u>   | 3587  |     |       |
| Dg <u>Tr 21</u> | 3603  |     |       |
| BL. <u>D9</u>   | 3652  |     |       |
| L.              |       |     |       |
| K.C.            |       |     |       |
| B.K.C.          |       |     |       |
| Ce.             |       |     |       |
| C.              |       |     |       |
| M.              |       |     |       |
| M.              |       |     |       |
| K.              |       |     |       |
| Mz.             |       |     |       |
| Mo.             |       |     |       |
| V.              |       |     |       |
| S.              |       |     |       |
| S.              |       |     |       |
| A.              |       |     |       |
| R.              |       |     |       |
| PE.             |       |     |       |
| G.              |       |     |       |
| TD.             | 3660  |     |       |


Loc in Sec. NE NE NE

Geol. \_\_\_\_\_

Contr. \_\_\_\_\_

Wilkinson, Tools

Pool \_\_\_\_\_

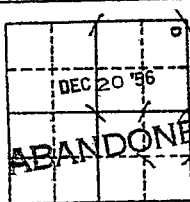

Date Comm. spd. 12-3-56 Superior (FO)

8" @ 190 W/125 DEC 12 '56 11 2170  
 DEC 19 '56

DST 3590-3603 op. 1 hr  
20" sec 110' 9554 Md + 60' V50C  
9554 Md + 70' SC 9554 Md  
FP 115 BHP 1290/20" DST  
3610-25 op 1 hr sec 30' GC  
E'50CM + 120' GC E'V50CWM +  
180' GCMW (Trace oil) FP 75-90  
BHP 1120/20 DE'A

ROF

SUNRAY

Co.

nty

Barber

Elev.

Sec.

22

Twp.

32

Rge.

11W

Company

Musgrove Pet.

FarmName

Gilbert

No. 1

Lse.

Sec.

T.

R.

TOPS

DEPTH

LOG

DATUM

Loc. in Sec.

Anh.

NE NE NE

TP.

H.

Tr.

Dg.

Bl.

L.

K.C.

B.K.C.

Ce.

C.

M.

M.

K.

Mz.

Me.

V.

S.

A.

R.

Pe.

G.


TD.

Geol.

Contr.

Wilkinson Tools

Pool

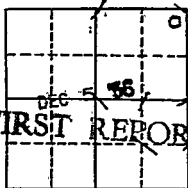

Date Comm. spd. 12-3-56

Superior (FO)

8" @ 190 w/125

26