


Barber **KANSAS**

SECTION 22 TOWNSHIP 32 RANGE 11W

WELL NO. #1 Schnelle

COMPANY Beardmore Drlg. & Barbara Oil Co.

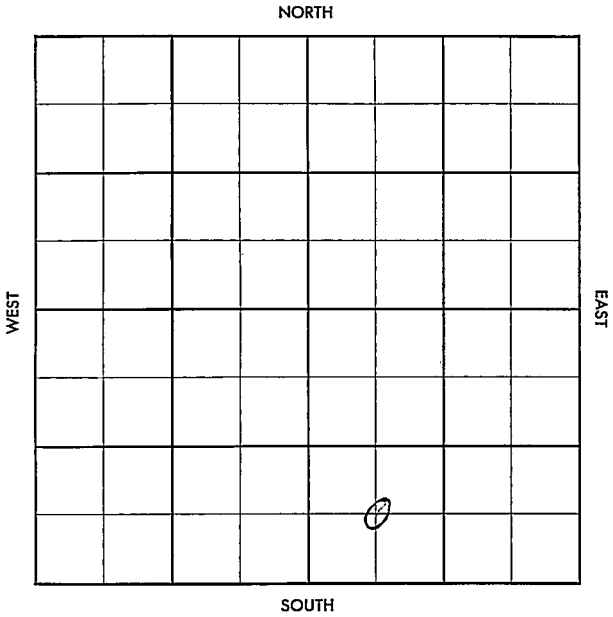

Date Comm. Phillips DHM - Magnolia AC
MIPT

MTPT

County Barber Elev. 1507
 Sec. 22 Twp. 32S Rge. 11W
 Company Beardmore Drlg. & Barbara Oil Co.
 Farm Name Schnelle No. 1

TOPS	DEPTH	LOG	DATUM	Loc. in Sec.
Apb.				C SW SE
TP.	3086			
H.	3569			
Tr.				
Dg.				
BL.				
L.	3748			Geol.
K.C.				
B.K.C.	4212			Contr.
Gr. <u>Marm</u>	4239			Beardmore
C.				Pool
M.	4417			Wildcat
M. <u>chata</u>	4611			
Mz.	4643			
Mo.				
V.	4648			
S. <u>sh</u>	4720			
S. <u>sd</u>	4728			
A.	4865			
R.				
PE.				
G.				
TD.	4910			

ABANDONED

OCT 24 '56

0

Date Comm. Phillips DHM - Magnolia AC

MTRP OCT 10 '56 10-6-56 85/8 180
 1120 M 2550 11 58 CR 3599-2614
 rec 15' DST 3674-85 or 50"
 rec 1950' SW FP 340-975
 BHP 1365/30 M 4310 OCT 24 '56
 DST 4418-58 45" rec 26'
 Md FP 28-32 BHP 95/30
 DST 4468-45 25 or 40" rec
 30' Mod' BHP 40/30" DST 4648

-65 or 30" rec 10' Md BHP
28/30" DST 4729-38 or 1m
rec 500 GSSy Md + 3196' SW
BHP 1850/30"

D E' A