


Section 23 Township 32 Range 11W
Well No. #1 McGuire
Company Superior

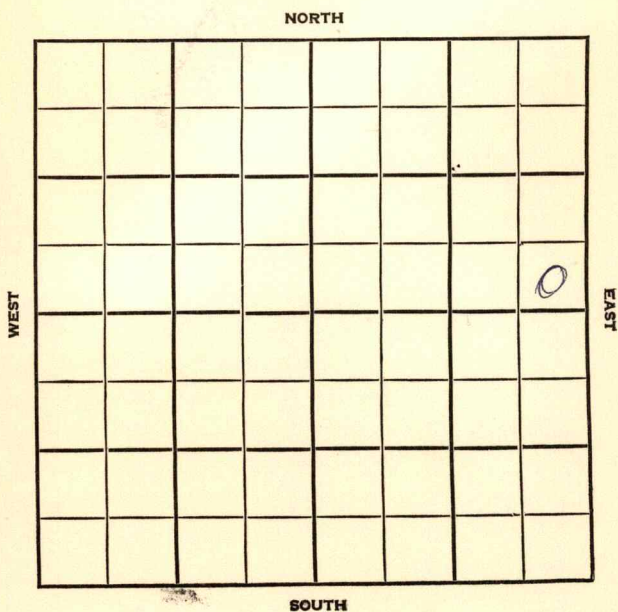

County Barber

Elev.

Sec. 23

Twp.

32

Rge.

11WCompany SuperiorFarm Name McGuire

No.

1

TOPS

DEPTH

LOG

DATUM

Loc. in Sec.

Anh.

Tp.

H.

Tr.

Dg.

B.L.

L.

K.C.

B.K.C.

Ce.

C.

M.

M.

K.

Mz.

Me.

V.

S.

S.

A.

R.

P.E.

G.

T.D.

SE SE NE

Geol.

Contr.

Barbour Tools

Pool

McGuire



Date Comm.

MIRT

28

County Barber Elev. 1505
 Sec. 23 Twp. 32 Rge. 11W
 Company Superior
 Farm Name McGuire No. 1

TOPS	DEPTH	LOG	DATUM	Loc. in Sec.
Anh.				SE SE NE
TP.				
H.	3575			
Tr.				
Dg.				
BL.				
L.				Geol.
K.C.				Contr.
B.K.C.				Barbour Tool
Ce.				Pool #7
C.	4394	4394		McGuire
M.				
M.				
K.				
Mz.				
Mo.				
V.				
S.				
S.				
A.				
R.				
Pe.				
G.				
TD.	4490			

ABANDONED

0

DEC 26 '56

Date Comm.

NIRT NOV 28 '54 11-22-56 85/8
 308 1/25 11-22-56 DEC 5 '56 11-3860

DEC 12 '56

DEC 19 '56

✓ DEC 26 '56

D & A (~~11-22-56~~)