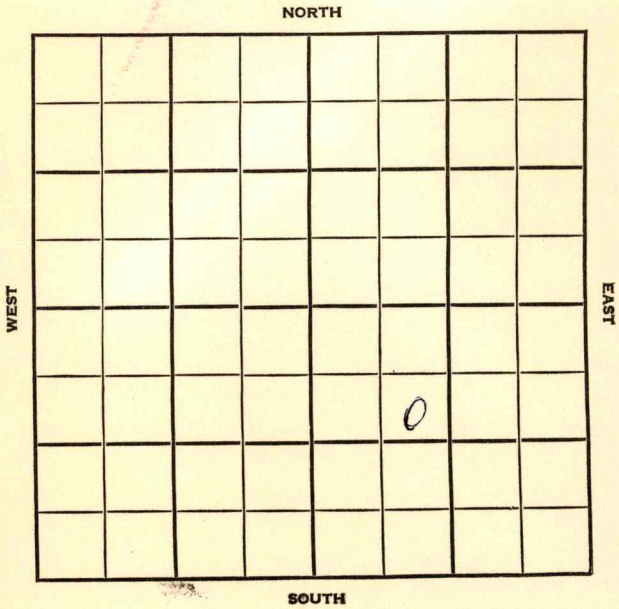


DX 78-1

Barber

Section 24 Township 32 Range 11WWell No. #1 Ryser-McGuireCompany Magnolia-Stenolind

County Barber Elev. 1494
 Sec. 24 Twp. 32 Rge. 11W
 Company Magnolia - Stanolind
 Farm Name Ryser-McGuire No. 1

TOPS	DEPTH	LOG	DATUM	Loc. in Sec.
Anh.				SE NW SE
Tr.				
Dg.				
BL.				
L.	3737	3731		Geol.
K.C.				Contr.
B.K.C.				
Ce.				Bass Tools
G. BP sd	4402	4399		
M. rework	4415	4412		
M.	4436	4434		Pool
K.				Goemann
Mz.				
Me.				
V.				
S.				
S.				
A.				
R.				
Pe.				
G.				
T.D.	4505			

COMPLETE
 JAN 23 '57

Date Comm. 11-23-56

9" @ 278 w/275, Drlg. 1855

DP 4179 DEC 12 '56 DST 4415 - 25
1hr G/1 1/2" ga 51.110 MCF/18"
rec 3' dist. BHP. 1670/30"
DST 4464 - 4504 1hr 90' GCM
FP 45-55 BHP 875 DST
45 44.36 - 61 1hr G/10" ga 98 MCF
15" 139 MCF/125" rec 110' GCM
BHP 1650/30" DST 4397 - 4410

78" gas/2" ga 3,210 MCF
 ga 4,720 MCF / 50" stable,
 rec 180' GCM BHP 1685/30"
 5 1/2 @ 4504 / 200 co 4478
 148 / 4413 - 17 4438 - 70

(1/2) + stg. DEC 19 '56 ga 1,20 MCF
 + Ld TP 420 CP 480 #
 Fvac 25 X 25 ga 5,210
 MCF 3/4" ch CP 1120 DEC 26 '56

JAN 2 '57

JAN 9 '57

JAN 16 '57

JAN 23 '57

cal op F/W 11,890 MCF G
 BHP 1557 # 51 TP 1381 #
 SICP 1401 #

County Barber

Elev. _____

Sec. 24Twp. 32Rge. 11W

Company _____

Magnolia

Farm Name _____

Ryser-McGuireNo. 1

TOPS

DEPTH

LOG

DATUM

Loc. in Sec. _____

Anh. _____

Tp. _____

H. _____

Tr. _____

Dg. _____

B.L. _____

L. _____

K.C. _____

B.K.C. _____

Ce. _____

C. _____

M. _____

M. _____

K. _____

Mz. _____

Me. _____

V. _____

S. _____

S. _____

A. _____

R. _____

Pe. _____

G. _____

T.D. _____

SE NW SE

Geol. _____

Contr. _____

Bass Tools

Pool _____

GoemannNOV 28 1955
FIRST REPORTDate Comm. 11-23-569" @ 278 w/275, Drlg. 185520