


Section 26 Township 32 Range 11W  
Well No. #1 Mildred S. Kimball  
Company Magnolia Petr. Co.

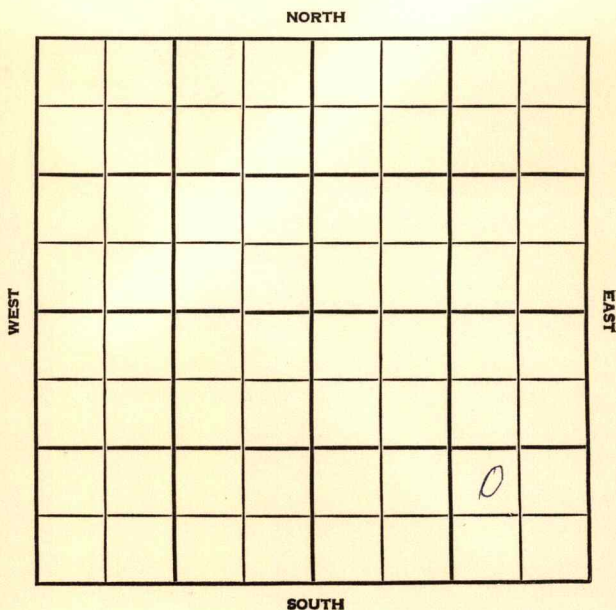

County Barber Elev. 1513  
 Sec. 26 Twp. 32 Rge. 11W  
 Company Magnolia Pet. Co.  
 Farm Name Mildred S. Kimball No. 1

TOPS	DEPTH	LOG	DATUM	Loc. in Sec.
Anh.				Nw SE SE
Tr.		3627		
Dg.		3665		
Bl.				
L.				Geol.
K.C.	3787	3787		Contr.
B.K.C.				Graham-Micha
Ce.				15 Tools.
M. chat	4453	4453		Pool
M.				Rhodes No.
K.				
Mz.				
Mo.				
V.				
S.				
S.				
A.				
R.				
PE.				
G.				
TR	4570	<del>4577</del>		

COMPLETE  
 DEC 5 '56

Date Comm.

MIHT NOV 13 '56 11-7-56 798 279  
 1275 @ 2915 NOV 21 '56 DST 4456  
 -75 @ 1 hr G/3" ga 1.70 MCF  
 15" 1.500 MCF / 10" 1.900 M / 25"  
 stabil rec 110' GCM BHP 1675/20"  
 DST 4478-4510 @ 1 hr G/3"  
 ga 887 MCF / 5" 1.20 MCF / 10" rec  
 90' GCM + 15' MW BHP 1600/20"  
 5 1/2 @ NOV 28 '56 @ 4569 / 200 CO

4535 80/4455-75  $\frac{1}{2}$  Flow  
Ld + 503 MCFG  $1\frac{5}{64}$ " ch TP 420  
CP 460# To FRC DEC 5 '56

25 X 25 F/d Ld + 4,260  
MCFG CP 1100#  $\frac{1}{2}$ " ch  
CALC. OF FLOW 7,800 MCFG.

County ~~Barber~~

Elev.

Sec. ~~26~~

Twp. 32

Rge.

11W

Company Magnolia Pet. Co.

Farm Name Mildred S. Kimball

No. 1

TOPS	DEPTH	LOG	DATUM
Anh.			
Tp.			
H.			
Tr.			
Dg.			
Bl.			
L.			
K.C.			
B.K.C.			
Ce.			
C.			
M.			
M.			
K.			
Mz.			
Mo.			
V.			
S.			
S.			
A.			
R.			
Pe.			
G.			
T.D.			

Loc. in Sec.

NW SE SE

Geol.

Contr.

Graham-Michael  
IS Tools.

Pool

Rhodes No.

FIRST REPORT	
NOV 7 '56	6

Date Comm.

MIRT

NOV 5 1956

R. G.

Co.

Log

No.

Sec.

T.

R.