


Barber

DX 78-1

Section 33 Township 32 Range 11 W

Well No. #1 C. D. Williams "B"

Company Magnolia Pet

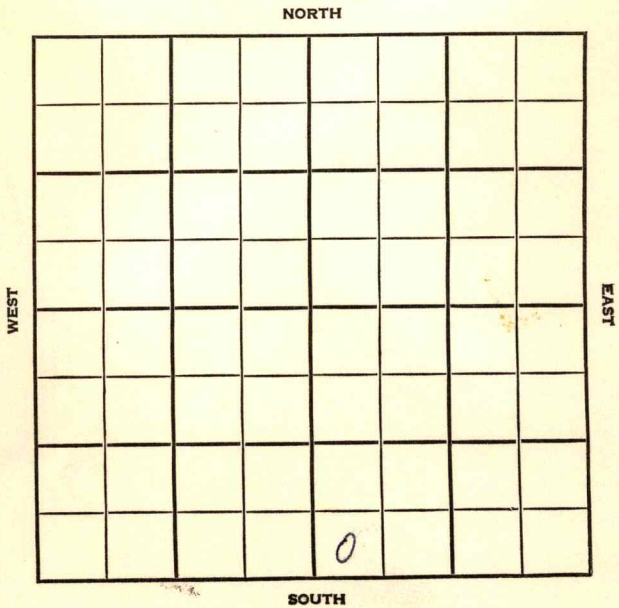

Barber

SEC.	TWP.	R.
33	32	11W

WELL NO.

#1 C. D. Williams "B"

FARM

Magnolia Pet.

CONTRACTOR

N. Rhoades


Ft. from N. Line

Ft. from S. Line

Ft. from E. Line

Ft. from W. Line

SW SW SE

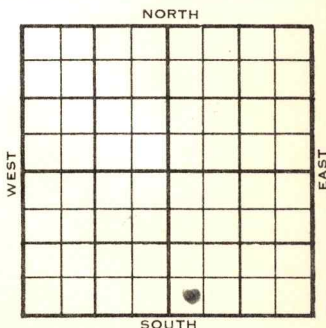

1955	ELEVATION	REPORT
	1500'	
8/3	Location	FIRST REPORT
9-7	Comm. 8-19-55	
	9 5/8" @ 360/325	
	DST 4438-65, open 1 hr., rec 25' mud	
	630/20"	
	DST 4467-4530, open 1 hr. rec. 15' mud	
	50/30"	
	D & A	
	<u>Tops</u>	<u>Depth</u>
	H.	3619
	Dg.	3747
	L.	3799
	M.	4437
	T.D. 4530	
		ABANDONED

[illegible]

County Barber Elev. 1500
 Sec. 33 Twp. 32 Rge. 11W
 Company Magnolia Pet.
 Farm Name C. D. Williams "B" No. 1

TOPS	DEPTH	LOG	DATUM	Loc. in Sec.
Anh.				SW SW SE
TP.				
H.	<u>3619</u>		<u>2119</u>	
Tr.				
Dg.	<u>3747</u>		<u>2247</u>	
BL.				
L.	<u>3799</u>		<u>2299</u>	Geol.
K.C.				Contr.
B.K.C.				<u>Mast</u>
Ce.				Pool
C.				<u>N. Rhoades</u>
M.	<u>4437</u>		<u>2937</u>	
M.				
K.				
Mz.				
Mq.				
V.				
S.				
S.				
A.				
R.				
PE.				
G.				
T.D.	<u>4530</u>			



Date Comm. 8-19-55 SEP 7 1955
9 5/8" @ 360/325 DST 4438-65 open 1 hr
Rec. 25' mud 630/20" DST 4467-4530
open 1 hr. Rec. 15' mud 50/30"
D & A