


Barber

KANSAS

SECTION 36 TOWNSHIP 32 RANGE 11W

WELL NO. #1 V.G. Coleman

COMPANY Stanolind

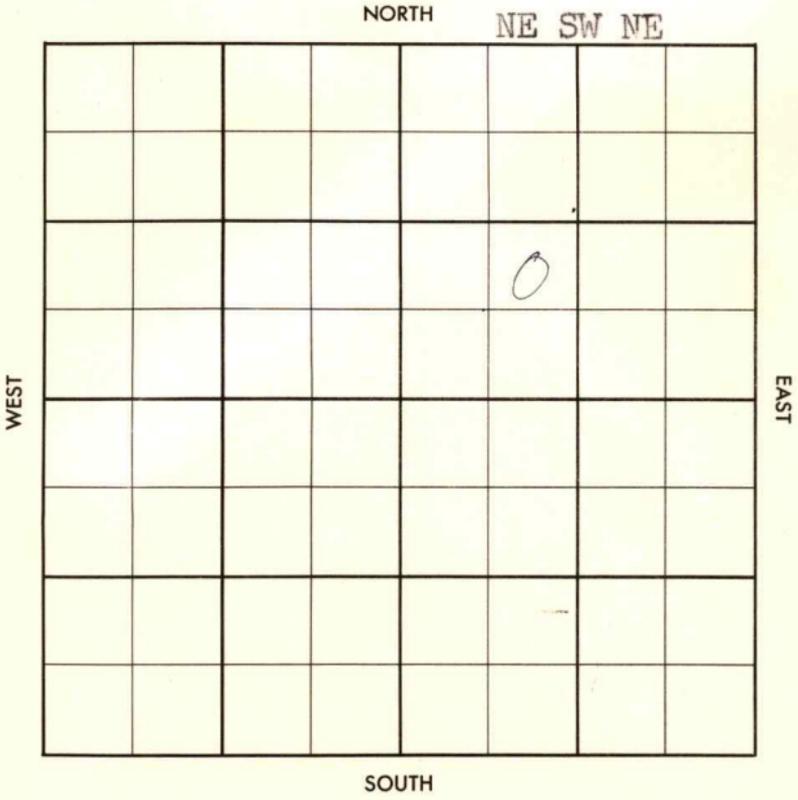

County Barber Elev. 1515
 Sec. 36 Twp. 32 Rgs. 11W
 Company Stanolind
 Farm Name V. G. Coleman No. 1

TOPS	DEPTH	LOG	DATUM	Loc. in Sec.
Anh. <u>Missourian</u>		<u>3782</u>		<u>NE SW NE</u>
Tr.				
Dg.				
Bl.				
L.				
K.C.				Geol. _____
B.K.C.				Contr. _____
Ce.				
C.				<u>Herndon</u>
M. <u>chert</u>		<u>4477</u>		
M. <u>LI</u>		<u>4503</u>		Pool _____
K.				<u>Rhodes</u>
Mr.				
Mq.				
V.				
S.				
S.				
A.				
R.				
Pe.				
G.				
TD		<u>4567</u>		

APR 17 '57
 COMPLETE

Date Comm. 1-17-57
8" @ 266/250 drlg. 2115 JAN 30 '57 @ 4005
FEB 6 '57 5 1/2 4566/250 FEB 13 '57 CO
4546 32/4480-88 1/2 F12C 10 X 16
9a 3,100 MCFGPD + Ld Wt
S.I. FEB 20 '57 ✓ FEB 27 '57 MAR 6 '57 MAR 13 '57
MAR 20 '57 MAR 27 '57 APR 3 '57 APR 10 '57 ✓ APR 17 '57
calc. op F/W 2,830 MCFGPD
SIP 1746 #

County Barber Elev. _____
 Sec. 36 Twp. 32 Rge. 11W
 Company Stanolind
 Farm Name V. G. Coleman No. 1

TOPS	DEPTH	LOG	DATUM	Loc. in Sec.
Anh.				NE SW NE
TP.				
H.				
Tr.				
Dg.				
BL.				
L.				Geol. _____
K.C.				Contr. _____
B.K.C.				
Ce.				Herndon
C.				
M.				
M.				Pool
K.				Rhodes
Mz.				
Me.				
V.				
S.				
S.				
A.				
R.				
PE.				
G.				
T.D.				

FIRST REPORT
 JAN 23 57

Date Comm. 1-17-57
3" @ 266/250 drlg. 2115

26

Co.
Lse.
No.
Sec.
T.
R.