DX 78-1

Barber

KANSAS

Section 36 Township 32 Range 11W

Well No. #1 Gramley

Company Aurora Gasoline & J-S & F

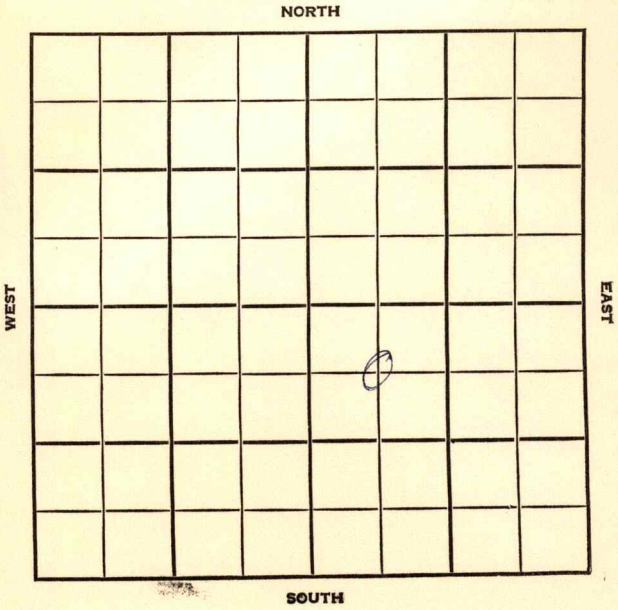

FORM 513 SUNRAY

County Barber Elev.

Sec. 36 Twp. 32 Rge. 11W

Company Aurora Gasloine

Farm Name Gramley No. 1

TOPS	DEPTH	LOG	DATUM
Anh.			
Tp.			
H.			
Tr.			
Dg.			
B.I.			
L.			
K.C.			
B.K.C.			
Ce.			
C.			
M.			
M.			
K.			
Mz.			
Mo.			
V.			
S.			
S.			
A			
R.			
P€.			
G.			
T.D.			

Loc. in Sec. C NW SE

Geol.

Contr. Jones, Shelb. Farmer Tools

Pool Rhodes

FIRST REPORT

NOV 2 '56

Date Comm. Spd. 11-17-56 Magnolia (FO)

8" @ 259 w/200, Drlg. 1825

Co.

Lse. &

No.

Sec.

T.

R.

FORM 513 SUNRAY

County: Barber Elev. 1523

Sec. 36 Twp. 32 Rge. 11W

Company: Aurora Gasloine & J S & F.

Farm Name: Gramley No. 1

TOPS	DEPTH	LOG	DATUM
Anh. Elg	3450		
Tp.			
H.	3590	3596	
Tr.		3609	
Dg. sd	3650	3648	
Bl.			
L.	3280	3784	
K.C.			
B.K.C.		4280	
Ce. sd	4461	4461	
C.			
M. Li	4466	4470	
M. chat	4481	4482	
K.			
Mz.			
Mo.			
V.			
S.			
S.			
A			
R.			
P€.			
G.			
T.D.	4527	4537	

Loc. in Sec. C NW SE

Geol.

Contr. Jones, Shelb. Farmer Tools

Pool Rhodes

COMPLETE

JAN 16 '57

Date Comm. spd. 11-17-56 Magnolia (FC)

8" @ 259 w/200, Drlg. 1825 NOV 28 '56

TD 4020 DEC 5 '56 DST 4482-4515

1hr 6/2½" ga 2,100 MCF/45'

ne 210' gcm FP 440-480

BHP 1220/20" 5½ 4526/150

WOC DEC 12 '56 CO 4518 GRNL 124

/4484-4515 ga 1,750 MCFG

1 Frac ga 4,500 MCF

3/4" ch TP 500 CP 1100# DEC 19 '56

JAN 2 '57 JAN 9 '57 JAN 16 '57

Co. Lse. No. Sec. T. R.

FORM 513-1 SUNRAY

CSO Absolute op Flow
9,750 MCFGPD