

C.W.W.O.

Barber


KANSAS

SECTION 25 TOWNSHIP 32 RANGE 11 W

WELL NO. #1 Lies

COMPANY Aurora Gasoline & Aylward Hely.
~~Aurora et al. Hely et al.~~

NORTH

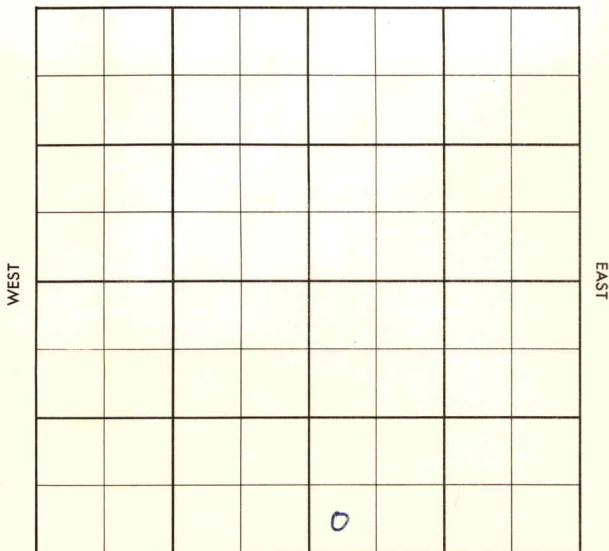

SOUTH

Barber

MINN. SAS

SEC.	TWP.	R.
25	32	11W

WELL NO.

#1 Lies

FARM

COMPANY

Aylward

~~Aurora et al~~

CONTRACTOR

Aylward

Wildcat


Ft. from N. Line

Ft. from S. Line

Ft. from E. Line

Ft. from W. Line

SW SW SE

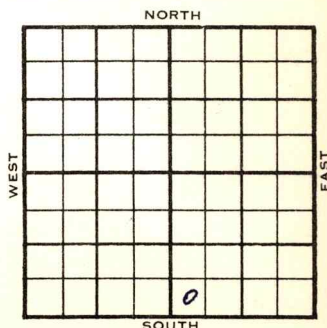

Sun, Gulf & Stanolind DHM

1955

ELEVATION

1503'

REPORT

11/9

Cellar & Pits

12-7

Comm. 11-16-55

8 5/8" @ 133

DST 3714-20 op 1/2 hr. rec. 435' sw,
1450#DST 4438-49 op 1 hr. gas in 27 min.
rec 35' mud, 1680/30"DST 4456-80 op 1 1/2 hr. gas in 12 min.
88 mcfg in 15 min., 76 mcfg in 35 min.
stabilized rec. 52' gcm, 1490/30"

D & A

Anh. 1400

H. 3595

Tr. 3614

Dg. 3630

Doug sd. 3710

L. 3766

Ce. 4441

M. 4455

TD 4505

ABANDONED

SCOUT TICKET

DX-201

SEC.

25

TWP.

32

R.

11W

WELL NO.

#1

Lies

FARM

COMPANY

Aylward

CONTRACTOR

SW SW SE

FT. FROM N. LINE


330

FT. FROM S. LINE

FT. FORM E. LINE

330

FT. FROM W. LINE

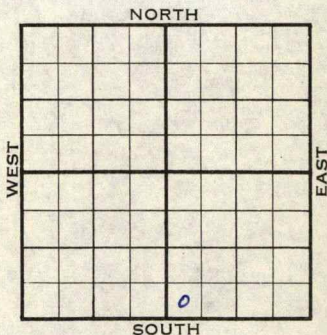

Barber County

☐

LOCATION

☐

RIG UP

DRILLING AND REMARKS:

Reported

Aurora etal.

RECORD

CASED IN., FT.

SAND

GAS

OIL

TOTAL DEPTH

PRODUCTION

1ST 24 HRS. NAT.

1ST 24 HRS. AFTER SHOT

GAS CU. FT.

DRY HOLE

ABANDONED

DATE

SCOUT

County Barber Elev. 1503
 Sec. 25 Twp. 32 Rge. 11W
 Company Aylward
 Farm Name Lies No. 1

TOPS	DEPTH	LOG	DATUM	Loc. in Sec.
Anh.	<u>1400</u>			<u>SW SW SE</u>
Tp.				
H.	<u>3595</u>		<u>2092</u>	
Tr.	<u>3614</u>		<u>2111</u>	
Dg.	<u>3630</u>		<u>2127</u>	
Bl. <u>Long. sh.</u>	<u>3710</u>		<u>2207</u>	
L.	<u>3766</u>		<u>2265</u>	Geol.
K.C.				
B.K.C.				Contr.
Ce.	<u>4441</u>		<u>2938</u>	<u>Aylward</u>
C.				
M.	<u>4455</u>		<u>2952</u>	Pool
M.				<u>Wildcat</u> ABANDONED
K.				
Mz.				
Ma.				
V.				
S.				
S.				
A.				
R.				
Pe.				
G.				
T.D.	<u>4505</u>			

Date Comm. 11-16-55 DEC 7 1955

8 5/8" @ 133 DST 3714-20 open 1 1/2 hr.

rec. 435' sw 1450# DST 4438-49

open 1 hr. gas in 27 min. rec. 35' mud

1680/30" DST 4456-80 open 1 1/2 hr.

gas in 12 min. 88 mcfg in 15 min.

76 mcfg in 35 min. stabilized rec. 52'

gcm 1490/30"

D & A

County Barber Elev. _____
 Sec. 25 Twp. 32 Rge. 11W
 Company Aurora etal.
 Farm Name Lies No. 1

TOPS	DEPTH	LOG	DATUM
Anh.			
Tp.			
H.			
Tr.			
Dg.			
B.L.			
L.			
K.C.			
B.K.C.			
Ce.			
C.			
M.			
M.			
K.			
Mz.			
Mq.			
V.			
S.			
S.			
A.			
R.			
Pe.			
G.			
T.D.			

Loc. in Sec. SW SW SE

Geol. _____

Contr. _____

Aylward

Pool _____

Wildcat

NOV 9 1955
 FIRST REPORT

Date Comm. Sun, Gulf & Stanolind DHM

Cellar & pits

26

O.W.W.O.

FORM 513 SUNRAY

County Barber Elev. _____
 Sec. 25 Twp. 32 Rge. 11W
 Company Aurora Gasoline & Aylward Drlg.
 Farm Name Lies No. 1

TOPS	DEPTH	LOG	DATUM	Loc. in Sec.
Anh.				SW SW SE
Tp.		3595		(OWWO)
H.		3614		
Tr.		3710		
Dg.				
Bl.				
L.		3766		Geol. _____
K.C.				Contr. _____
B.K.C.				
Ce.				
C.		4455		Pool _____
M.				Rhodes
M.				
K.				
Mz.				
Mq.				
V.				
S.				
S.				
A.				
R.				
Pe.				
G.				
TD.		4505		

Date Comm. 07D 4505
Old Info. was D & A, New Info. CO, TD 4505
running 5 1/2"

~~26~~

OWWO

FORM 513 SUNRAY

County Barber Elev. 1503 DF
Sec. 25 Twp. 32 Rge. 11W
Company Aurora Gasoline & Aylward Drlg.
Farm Name Lies No. 1

TOPS	DEPTH	LOG	DATUM	Loc. in Sec.
Anh.				SW SW SE
Tp.				(O.W.O)
H.		3595		
Tr.		3514		
Dg.		3710		
BL.				
L.		3766		Geol.
K.C.				Contr.
B.K.C.				
Ce.				
C.		4455		
M.				Pool
M.				Rhodes
K.				
Mz.				
Me.				
V.				
S.				
A.				
R.				
Pe.				
G.				
TD		4505		

COMPLETE

Date Comm.
Old Info. was D & A, New Info. CO, TD 4505
running 5 1/2" JAN 2 57 9 1/2 4505/75
CO JAN 8 57 84/4454-75 FRAC
15 x 15 8' ld + 9a 3 MIH CFC
JAN 16 57 water JAN 23 57 JAN 30 57
FEB 6 57 CSO 9a 2,400 MCFG
PD CP 1496# TP 1492#