

Barber


KANSAS

SECTION 26 TOWNSHIP 32 RANGE 11W

WELL NO. #1 Stone "C"

COMPANY Jones, Shelburne & Farmer

NORTH

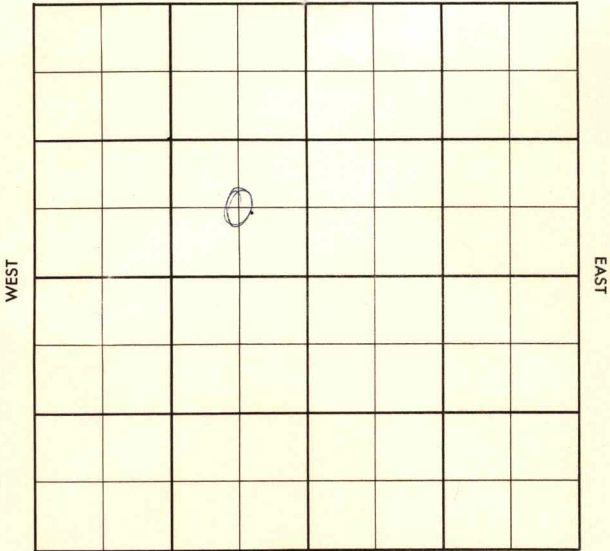

SOUTH

County Barber Elev. _____
 Sec. 26 Twp. 32 Rge. 11W
 Company Jones, Shelburne & Farmer
 Farm Name Stone "C" No. 1

TOPS	DEPTH	LOG	DATUM	Loc. in Sec.
Anh.				C SE NW
Tp.				
H.				
Tr.				
Dg.				
Bl.				
L.				Geol. _____
K.C.				Contr. _____
B.K.C.				
Ce.				Co. tools _____
C.				
M.				Pool _____
M.				
K.				Rhodes _____
Mz.				
Me.				
V.				
S.				
S.				
A.				
R.				
PE.				
G.				
T.D.				

JAN 3 '57
 0
 FIRST REPORT

Date Comm. 12-28-56 Gulf - 1/2 int.
8" @ 240/200 d rlg. 2845 Aurora - 1/4 int.

[Handwritten signature]

Co.
No.
Sec.
T.
R.

Co.

County Barber Elev. 1496

Sec. 26 Twp. 32 Rge. 11W

Company Jones, Shelburne & Farmer

Farm Name Stone "C" No. 1

Loc.

No.

Sec.

T.

R.

TOPS	DEPTH	LOG	DATUM
Anh.			
TP.			
H.	<u>3565</u>		
Tr.			
Dg.	<u>3599</u>		
BL.			
L.	<u>3746</u>	<u>3752</u>	
K.C.			
B.K.C.			
Ce.			
C.			
M.	<u>4406</u>	<u>4408</u>	
M.	<u>LI 4453</u>	<u>4464</u>	
K.			
Mz.			
Mo.			
V.			
S.			
S.			
A.			
R.			
PE.			
G.			
TD.	<u>4472</u>	<u>4462</u>	<u>4474</u>

Loc. in Sec. C SE NW

Geol.

Contr.

Co. tools

Pool

Rhodes

FEB 27 '57	
o	
COMPLETE	

Date Comm. 12-28-56

Gulf - 1/2 int.
Aurora - 1/4 int.

8" @ 240/200 drlg. 2845

4157 JAN 19 '57 DST 4406-35 1 km.

G/2 1/2" ga 560 MCF/1 km. BHP

1635/20" DST 4435-63 30" rev

6' Md BHP 0 3/2 @ 4462/150

JAN 23 '57 SLM 4463 = 4472

5 1/2 @ 4471 JAN 30 '57 CO 84/4424-38

ga 500 MCFG 1/2 ga 750 MCFG

Frac ga 1 1/2 MHW CFG 3/4" ch

FEB 6 '57 ga 1.20 MCFG CP400

TP 0 FEB 13 '57 WOTST FEB 20 '57 FEB 27 '57

ga 1.900 MCFG PD