


Barber

KANSAS

SECTION 26 TOWNSHIP 32S RANGE 11W

WELL NO. #1 Stone "C"

COMPANY Phillips Petroleum

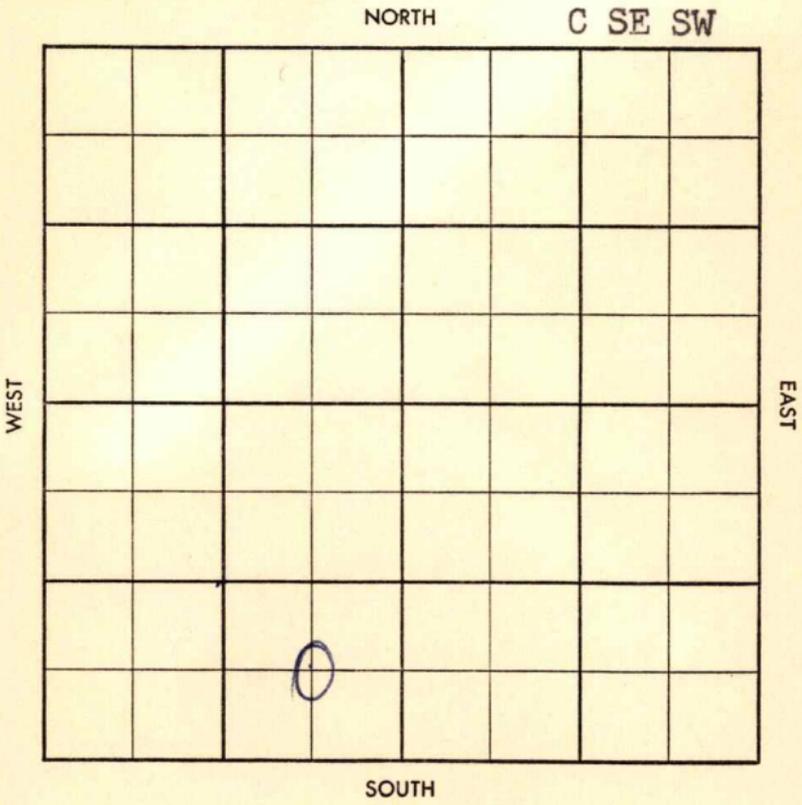

Twp. 32 Pool X
 Co. X Facet X

5-513-B

County Barber Elev. 15140 or 15188
 Sec. 26 Twp. 32 Rge. 11W
 Company Phillips Petroleum
 Farm Name Stone "C" No. 1

TOPS	DEPTH	LOG	DATUM	Loc. in Sec.
Anh.				c SE SW
Tp.				
H.	<u>3572</u>			1980' fwl x
Tr.				660' fsl
Dg.				
B.L.	<u>3765</u>			
L.				
K.C.	<u>3770</u>			Geol.
B.K.C.	<u>4242</u>			Contr.
Ce. <u>norm</u>	<u>4252</u>			<u>Strata Drlg.</u>
C.				
M.		<u>4426</u>		Pool
M.				<u>Rhodes</u>
K.				
Mz.				
Mq.				
V.				
S.				
S.				
A.				
R.				
Pf.				
G.				
T.D.	<u>4518</u>			

COMPLETE
 JUN 11 '58

Date Comm. 2-12-58
 Location FEB 19 '58 8" 276/250 @ 2900
FEB 26 '58 @ 4420 MAR 4 '58 5 1/2 4516/50
MAR 12 '58 CO 4490 B day 40/4427-37
SO nat (1/2) 9Ld + 4B New 0 5B
W ~~SO~~ MAR 19 '58 ~~SO~~ frac F10
Ld + 1.400-mfp pd 48/64" chd^{oo}
FTP 230 FCP 450 F10^{oo} Ld
+ 1.360-mfp pd TP 200 CP 400
S/ MAR 26 '58 APR 2 '58 APR 9 '58 APR 16 '58 APR 23 '58
APR 30 '58 MAY 7 '58 MAY 14 '58 MAY 21 '58 MAY 28 '58 JUN 3 '58

CSO Open Flo 2,600 mft +
to Boph FCP/110

Miss 4427-37

⊕