


Section 34 Township 32 Range 11W

Well No. 1 Wheat

Company Petroleum, Inc.

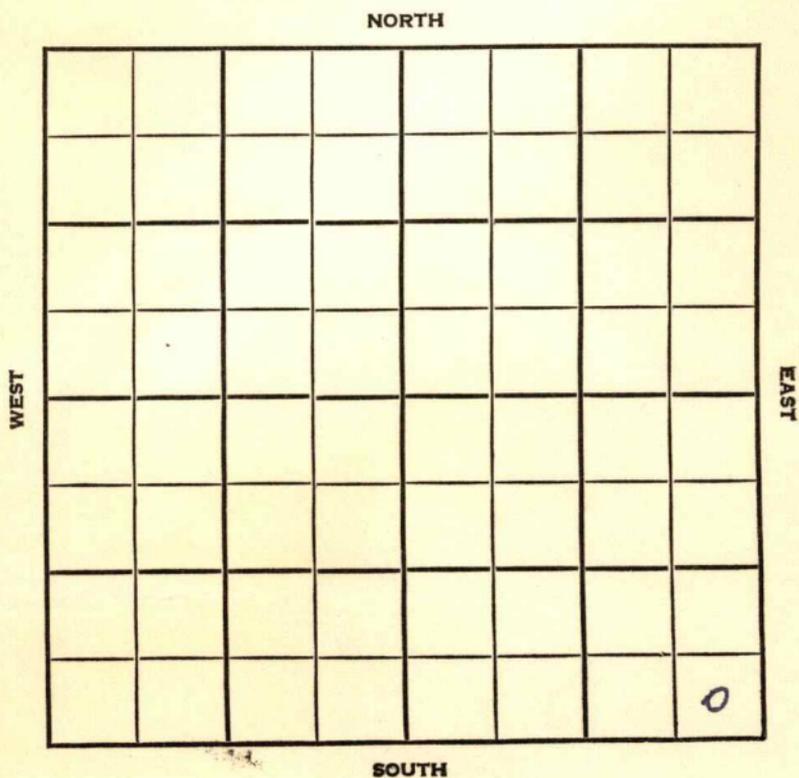

KANSAS

Barber

SEC. TWP. R.

WELL NO. 34 32 11W

#1 Wheat

FARM

COMPANY

Petroleum Inc.

CONTRACTOR

Garvey Drlg.


Wildcat.

Ft. from N. Line

330 Ft. from S. Line

330 Ft. from E. Line

Ft. from W. Line

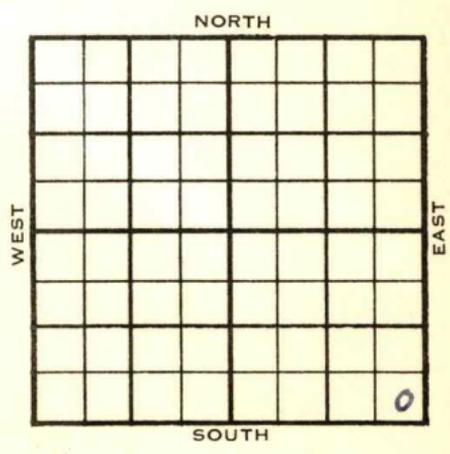

SE SE SE
Gulf & Sinc. support.

ELEVATION

REPORT

1955

1545'

3/23

Spud 3-18-55

8" @ 280'

Drlg. 2535'

4/13

Spud 3-18-55 D & A TD 5015'

8" @ 280 Elgin 3435', Elgin sd 3500'

DST 3468-3535, open 1 hr rec 25' mud

0# Heeb 3624' Doug 3685'

DST 3685-3740 open 1/2 hr rec 25' mud

0#. DST 3811-27 open 1 hr rec 400' MW

1250#. Lans 3830 B KC 4310'

Marm 4493 DST 4497-4515, open 1/2 hr r

15' mud. 20# Miss. chat 4500'

Kh. 4658', Misener 4762'

DST 4760-65, failed. DST 4760-65,

open 1 hr rec 20' 0 & SGM, 260#

Viola 4771'

DST 4866-83 open 1 hr rec 62' SO &

GCM, 1480'.

DST 4896-4914 open 1 hr rec 330'

MCGW 1800# Viola 4771' Simp sh 4859

Simp. sd. 4866' Arb. 4977' TD 5015'

D & A

ABANDONED

Drig. Data

Simp. sd. 4866

Arb. 4977

TD 5015

D & A

Scout Cards
Land Small Map
Land Wall Map
Tracings
France Map
France Map
Misc

APR 20 1955

[Handwritten signature]