

15-007-20746

State Geological Survey
**WELL COMPLETION REPORT AND
 DRILLER'S LOG**

KANSAS

S. 5 T. 32 R. 12 ^EW
 Loc. 2110' FWL & 1910' FSL
 County Barber

API No. 15 — 007 — 20746
 County Number

Operator
 Texas Oil & Gas Corp.

Address
 200 West Douglas, Suite 300, Wichita, KS 67202


Well No. #1 Lease Name Turnbull

Footage Location
 1910 feet from (N) (S) line 2110 feet from (E) (W) line

Principal Contractor Slawson Drilling Co. Geologist Glenn D. Tracy

Spud Date 5-19-79 Date Completed 6-26-79 Total Depth 4291' P.B.T.D. 4232'

Directional Deviation not directionally drilled Oil and/or Gas Purchaser Peoples Natural Gas

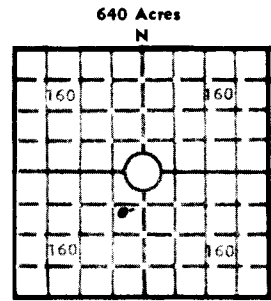

Elev.: Gr. 1490'
 DF _____ KB 1496'

CASING RECORD

Report of all strings set — surface, intermediate, production, etc.

Purpose of string	Size hole drilled	Size casing set (in O.D.)	Weight lbs/ft.	Setting depth	Type cement	Sacks	Type and percent additives
Surface		8-5/8"	24#	304'	lite common	150	
Production		2-7/8"		4290'		175	

LINER RECORD

Top, ft. N/A	Bottom, ft. N/A	Sacks cement N/A
--------------	-----------------	------------------

PERFORATION RECORD

Shots per ft. 2	Size & type 2-7/8"	Depth interval 4214-34'
-----------------	--------------------	-------------------------

TUBING RECORD

Size N/A	Setting depth N/A	Packer set at N/A
----------	-------------------	-------------------

ACID, FRACTURE, SHOT, CEMENT SQUEEZE RECORD

Amount and kind of material used	Depth interval treated
Acidized w/500 gals. 15% HCL & 1500 gals. 7 1/2% HCL & 1 1/2% HF w/20 ball sealers	4214-34'
Frac w/80,000 gal. Ultra-Aqua & 160,000 lb. sand	4214-34'

INITIAL PRODUCTION

Date of first production 10-18-79	Producing method (flowing, pumping, gas lift, etc.) flowing
RATE OF PRODUCTION PER 24 HOURS	Oil N/A bbls. Gas 250 MCFD MCF Water 30 BW bbls. Gas-oil ratio N/A CFPB
Disposition of gas (vented, used on lease or sold) sold	Producing interval(s) 4214-34'

INSTRUCTIONS: As provided in KCC Rule 82-2-125, within 90 days after completion of a well, one completed copy of this Drillers Log shall be transmitted to the State Geological Survey of Kansas, 4150 Monroe Street, Wichita, Kansas 67209. Copies of this form are available from the Conservation Division, State Corporation Commission, 245 No. Water, Wichita, Kansas 67202. Phone AC 316-522-2206. If confidential custody is desired, please note Rule 82-2-125. Drillers Logs will be on open file in the Oil and Gas Division, State Geological Survey of Kansas, Lawrence, Kansas 66044.

Operator Texas Oil & Gas Corp.

DESIGNATE TYPE OF COMP.: OIL, GAS, DRY HOLE, SWDW, ETC.:

Well No. #1

Lease Name Turnbull

gas

S 5 T 32 R 12 E W

WELL LOG

Show all important zones of porosity and contents thereof; cored intervals, and all drill-stem tests, including depth interval tested, cushion used, time tool open, flowing and shut-in pressures, and recoveries.

SHOW GEOLOGICAL MARKERS, LOGS RUN, OR OTHER DESCRIPTIVE INFORMATION.

FORMATION DESCRIPTION, CONTENTS, ETC.	TOP	BOTTOM	NAME	DEPTH
Herington	1788	-292		
Cottonwood	2388	-892		
Indian Cave	2618	-1122		
Wabaunsee	2656	-1159		
Topeka	3040	-1544		
Heebner	3506	-2010		
Top Douglas grp.	3546	-2050		
Douglas ss	3650	-2154		
Swope	4048	-2332		
Hertha	4088	-2592		
Mississippi	4214	-2718		
TD	4291			
PBTD	4232			
No DST's.				

USE ADDITIONAL SHEETS, IF NECESSARY TO COMPLETE WELL RECORD.

Date Received

Harold A. Brown

HAROLD A. BROWN

Signature

District Exploration Manager

Title

October 19, 1979

Date

DRILLERS LOG

State Geological Survey
WICHITA BRANCH

OPERATOR: Texas Oil & Gas Corp.
200 West Douglas, O. W. Garvey Building
Wichita, Kansas 67202

LEASE: Turnbull #1
2110' FWL & 1910' FSL
Sec. 5-~~33~~S-12W 325
Barber County, Kansas

CONTRACTOR: Slawson Drilling Company, Inc.
200 Douglas Building
Wichita, Kansas 67202

COMMENCED: 5/19/79

COMPLETED: 5/26/79

RTD: 4291'

SURFACE CASING: 8-5/8" set at 304' with 300 sx cement

PRODUCTION CASING: 4-1/2" set at 4290' with 175 sx cement.

0' to 314' 12 1/4" Surface Hole
314' to 1650' Shale
1650' to 2480' Shale & Lime
2480' to 3215' Shale
3215' to 3765' Shale & Lime
3765' to 3905' Lime & Shale
3905' to 4024' Lime
4024' to 4140' Lime & Shale
4140' to 4291' Lime
RTD 4291'

STATE OF KANSAS

COUNTY OF SEDGWICK

I, James C. Remsberg, of the Slawson Drilling Company, Inc. hereby state the above is an accurate copy of the Turnbull log for Texas Oil & Gas Corp.


James C. Remsberg

Subscribed and sworn to me this
1st day of June, 1979

RECEIVED
STATE CONSERVATION COMMISSION

JUN - 5 1979

CONSERVATION DIVISION
Wichita, Kansas