

3121186
3-21-87
RCC
TAD

RELEASED

SIDE ONE

STATE CORPORATION COMMISSION OF KANSAS
OIL & GAS CONSERVATION DIVISION
WELL COMPLETION OR RECOMPLETION FORM
FROM CONFIDENTIAL WELL HISTORY
DESCRIPTION OF WELL AND LEASE

Operator: License # 4105
Name Bush Oil & Gas
Address P.O. Box 627
City/State/Zip Winfield, KS 67156

Purchaser

Operator Contact Person
Phone

Contractor: License # 5107
Name H-30, Inc.

Wellsite Geologist
Phone

Designate Type of Completion

☒ New Well ☐ Re-Entry ☐ Workover

☐ Oil ☐ SWD ☐ Temp Abd
☐ Gas ☐ Inj ☐ Delayed Comp.
☒ Dry ☐ Other (Core, Water Supply etc.)

If OMWO: old well info as follows:

Operator
Well Name
Comp. Date Old Total Depth

WELL HISTORY

Drilling Method:

☒ Mud Rotary ☐ Air Rotary ☐ Cable

12-16-85 12-21-85 12-21-85
Spud Date Date Reached TD Completion Date

3560'
Total Depth PBTD

Amount of Surface Pipe Set and Cemented at 218 feet
Multiple Stage Cementing Collar Used? Yes No
If yes, show depth set feet
If alternate 2 completion, cement circulated
from feet depth to w/SX cmt
Cement Company Name
Invoice #

API NO. 15-007-22,110
County Barber
C SE SE 8 32S 12 East
Sec Twp Rge XX West

660 Ft North from Southeast Corner of Section
660 Ft West from Southeast Corner of Section
(Note: Locate well in section plat below)


Lease Name Clarke Well #1

Field Name Wildcat

Producing Formation

Elevation: Ground 1569 KB 1574

Section Plat

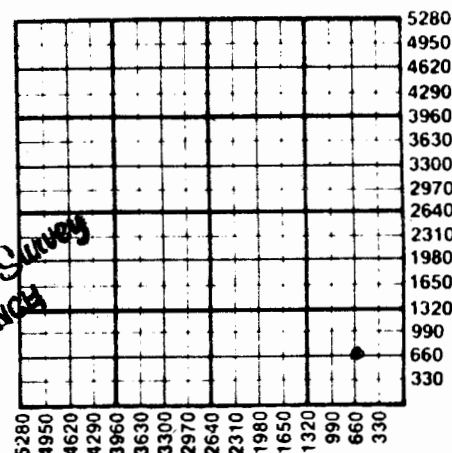

WATER SUPPLY INFORMATION

Disposition of Produced Water: Disposal
Docket # Repressuring

Questions on this portion of the ACO-1 call:
Water Resources Board (913) 296-3717

Source of Water:
Division of Water Resources Permit #

Groundwater Ft North from Southeast Corner
(Well) Ft West from Southeast Corner of
Sec Twp Rge East West

Surface Water Ft North from Southeast Corner
(Stream, pond etc) Ft West from Southeast Corner
Sec Twp Rge East West

Other (explain)
(purchased from city, R.W.D. #)

INSTRUCTIONS: This form shall be completed in duplicate and filed with the Kansas Corporation Commission, 200 Colorado Derby Building, Wichita, Kansas 67202, within 90 days after completion or recompletion of any well. Rule 82-3-130 and 82-3-107 apply.

Information on side two of this form will be held confidential for a period of 12 months if requested in writing and submitted with the form. See rule 82-3-107 for confidentiality in excess of 12 months.

One copy of all wireline logs and drillers time log shall be attached with this form. Submit CP-4 form with

SIDE TWO

Operator Name Rush Oil & Gas Lease Name Clarke Well # 1

Sec. 8 Twp. 32S Rge. 12 ☐ East ☒ West County Barber

WELL LOG

INSTRUCTIONS: Show important tops and base of formations penetrated. Detail all cores. Report all drill stem tests giving interval tested, time tool open and closed, flowing and shut-in pressures, whether shut-in pressure reached static level, hydrostatic pressures, bottom hole temperature, fluid recovery, and flow rates if gas to surface during test. Attach extra sheet if more space is needed. Attach copy of log.

Drill Stem Tests Taken ☐ Yes ☒ No
 Samples Sent to Geological Survey ☐ Yes ☐ No
 Cores Taken ☐ Yes ☒ No

Formation Description
☐ Log ☐ Sample

Log Tops		Name	Top	Bottom
Indian Cave	2689 (-1115)	top soil	0	40'
Wabunsee	2745 (-1171)	red bed	40'	222'
Queen Hills Shale	3505 (-1931)	shale	222'	568'
Base Lecompton	3509 (-1935)	shale, lime	568'	1770'
		lime, shale	1770'	2025'
		shale, lime	2025'	2575'
		lime, shale	2575'	3560'
		Rotary total depth	3560'	

CONFIDENTIALCASING RECORD ☐ New ☐ Used

Report all strings set-conductor, surface, intermediate, production, etc.

Purpose of String	Size Hole Drilled	Size Casing Set (in O.D.)	Weight Lbs/Ft.	Setting Depth	Type of Cement	#Sacks Used	Type and Percent Additives
surface	12-1/4	8-5/8	23#	218'	Class A	125	3%cc..2%gel..
.....							
.....							
.....							

PERFORATION RECORD

Shots Per Foot	Specify Footage of Each Interval Perforated	Acid, Fracture, Shot, Cement Squeeze Record (Amount and Kind of Material Used)	Depth
.....			
.....			
.....			
.....			

TUBING RECORD	Size	Set At	Packer at	Liner Run ☐ Yes ☐ No
.....				