
FORM 51 25M 8-50 WESTERN KANSAS Barber

Section 22 Township 32 Range 12-W

Well No. #1 Gillespie

Company Aurora Gas Co.

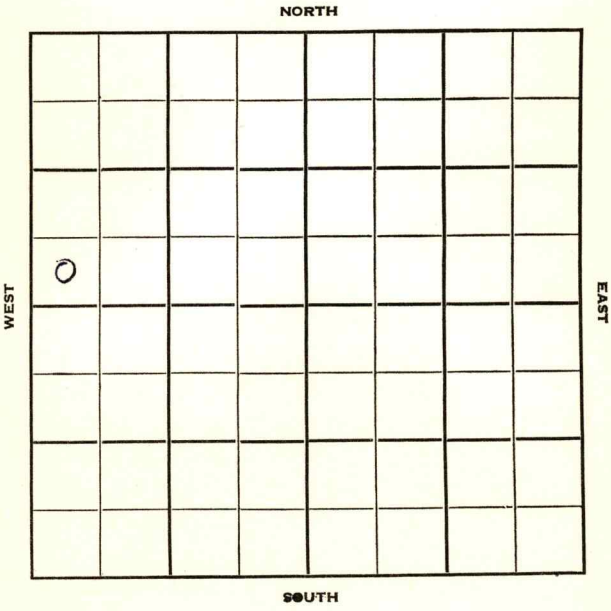

FORM 252-B
10M 11-50 PETROL

HOT FILE

Barber KANSAS ✓

Sec. 22 Twp. 32 R. 12W

Well No. #1 Gillespie Farm

Aurora Gas Co. Company

Beardmore Drlg. - Contr. Contractor

Wildcat


Ft. from N. Line

330' Ft. from S. Line

Ft. from E. Line

330' Ft. from W. Line

SW SW NW MCPC has SWof 21

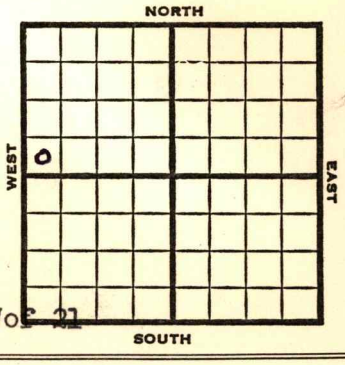

1951	Elv. 1535' REPORT
1/10	Location
2/14	Spud 1-15-51 D&A TD 4865 8" @ 164' Heeb. 3580' Douglas 3723' DST 3726-38 opn 1 hr Rec. 700' sw Lans. 3790' Miss 4349' DST 4395-4425 opn 30 min Rec. 30' ocm Kinderhook 4509' Chattanooga 4578' Misenor 4614' Viola 4616' DST 4617-36 opn 30 min Rec. 30' ocm Simp 4710' Sand 4735' DST 4717-43 opn 1 hr. Rec. 10' socm Arb. 4810-65 TD D&A ABANDONED

FORM 275 FOR SALE BY KANSAS BLUE PRINT CO.


County Barber State Kansas

Sec. 22 (Blk. Twp.) 32 (Sur. Rge.) 12W Map No.

Operator Aurora Gas Co.

Well No. 1 Farm Gillespie

Elev. Location SW SW NW

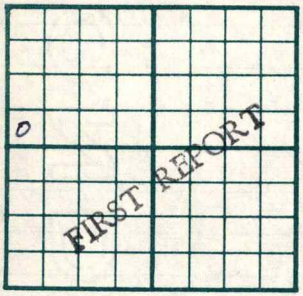

330 Ft. From S Line NW

330 Ft. From W Line Quarter

1st. Report JAN 1 0 1951

Completion

Remarks MCPC has SW of 21

Gulf DHM

Spudding Date

Drlg. Data Wildcat

Location

J. E. TYRA

FORM 275 FOR SALE BY KANSAS BLUE PRINT CO.

County Barber State Kansas

Sec. 22 (Blk. Twp.) 32 (Sur. Rge.) 12W Map No.

Operator Aurora Gas Co.

Well No. 1 Farm Gillespie

Elev. 1535 Location SW SW NW



330 Ft. From S Line NW

330 Ft. From W Line Quarter

1st. Report

Completion FEB 14 1951

Remarks Wildcat

Beardmore Drlg. - Contr.

Spudding Date 1-15-51

Drlg. Data D & A TD 4865

8" @ 164 Heeb. 3580 Douglas 3723

DST 3726-38 open 1 hr. Rec. 700' sw

Lans. 3790 Miss. 4349 DST 4395-4425

open 30 min. Rec. 30' ocm Kinderhook 4509

Chattanooga 4578 Misenor 4614 Viola 4616

DST 4617-36 open 30 min. Rec. 30' ocm

Simp. 4710 Sand 4735 DST 4717-53

open 1 hr. Rec. 10' socm Arb. 4810-65 TD

D & A

J. E. TYRA