


Section 22 Township 32 Range 12W

Well No. #1 Gillespie

Company Adair Oil

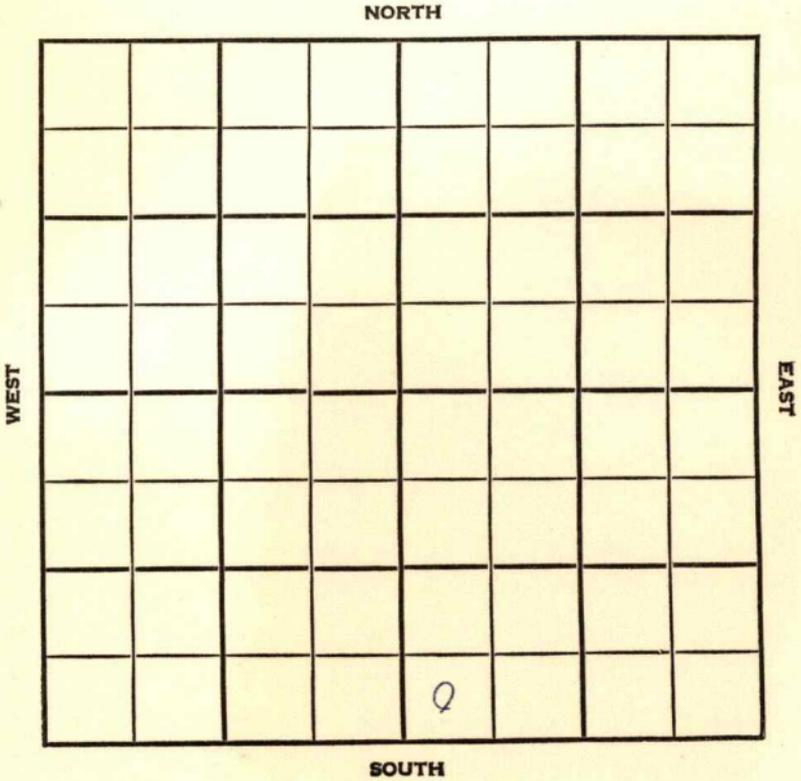

SEC. 22	TWP. 32	R. 12W
------------	------------	-----------


WELL NO. #1 Gillespie FARM

COMPANY Adair Oil

CONTRACTOR Co. Tools

WILDCAT

_____ FT. FROM N. LINE
 _____ FT. FROM S. LINE
 _____ FT. FROM E. LINE
 _____ FT. FROM W. LINE

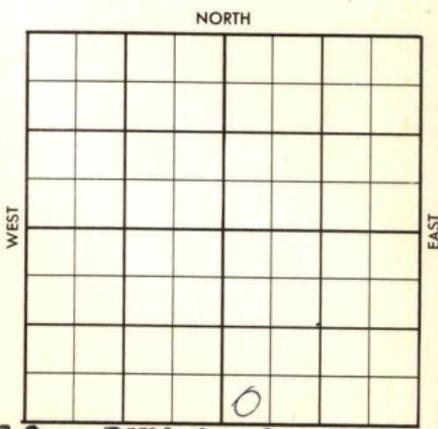

SW SW SE

Bulf - DHM & FO
 Skelly - DHM

1956	ELEVATION 1494'	REPORT
------	--------------------	--------

7-3 Comm. 7-1-56
 8" * 205 w/175
 Drlg. 2000'

7-25 DST 3572-90 op 1 hr. rec. 120' SOCM /
 60' MW, BHP 940/20".
 DST 4600-22 op 90 min., gas to surf. in
 29 min,; ga. 85 MCF, rec. 70' mud, /
 SSO BHP 675/20".
 DST 4725-51 op 1 hr. rec. 10' mud,
 BHP 0#.
 D & A
 Elg. 3388'; H. 3559'; Dg. 3573';
 BL. 3757'; L. 3764'; M. 4256';
 K. 4498'; Chata 4572'; V. 4606';
 S. 4712'; Sdy Dolo 4728';
 TD 4751'

ABANDONED

County Barber Elev. 1474
 Sec. 22 Twp. 32 Rge. 12W
 Company Adair Oil
 Farm Name Gillespie No. 1

TOPS	DEPTH	LOG	DATUM	Loc. in Sec.
Anb. <u>E19</u>	<u>3388</u>			SW 3W SE
Tp.				
H.	<u>3559</u>			
Tr.				
Dg.	<u>3573</u>			
Bl.	<u>3757</u>	<u>3746</u>		
L.	<u>3764</u>	<u>3754</u>		
K.C.				Geol.
B.K.C.				Contr.
Ce.				Co. tools
C.				
M.	<u>4256</u>			
M.				Pool
K.	<u>4498</u>			Wildcat
M. <u>chata</u>	<u>4572</u>			
Me.				
V.	<u>4606</u>			ABANDONED
S.	<u>4712</u>			
S. <u>sd4 Dobb</u>	<u>4728</u>			
A.				
R.				JUL 25 1956
PE.				
G.				
TD.	<u>4751</u>			

Date Comm. 7-1-56 Spelly - BHM
 Gulf - D.M. & CO
8" @ 205/175 dri. 2000 JUL 11 '56

DST 3572-90 1 hr rec 120'
500M + 60' MW BHP 940/20"
Ø 3790 JUL 18 '56 DST 4600-22
90" g to 5 29" ga 85 MCF
rec 70' Mud + 550 BHP 675/20"
Ø 4672 JUL 25 '56 DST 4725-51 1 hr
10' Md BHP 0
D & A

26

County Barber Elev. _____
 Sec. 22 Twp. 32 Rgs. 12W
 Company Adair Oil
 FarmName Gillespie No. 1

Co.

TOPS	DEPTH	LOG	DATUM
Anh.			
Ip.			
H.			
Tr.			
Dg.			
Bl.			
L.			
K.C.			
B.K.C.			
Ce.			
C.			
M.			
M.			
K.			
Mz.			
Ma.			
V.			
S.			
S.			
A.			
R.			
Pe.			
G.			
T.D.			

Loc. in Sec. SW SW SE

Geol. _____
 Contr. Co. tools

Pool Wildcat

FIRST REPORT
 JUL 3 '56
 6

Loc.

No.

Sec.

T.

R.

Date Comm. 7-1-56 Skelly - DHM
Gulf - DHM & FO
8" @ 205/175 drls. 2000

