


Section 24 Township 32 Range 12 W

Well No. #1 Smith

Company Aurora Gasoline

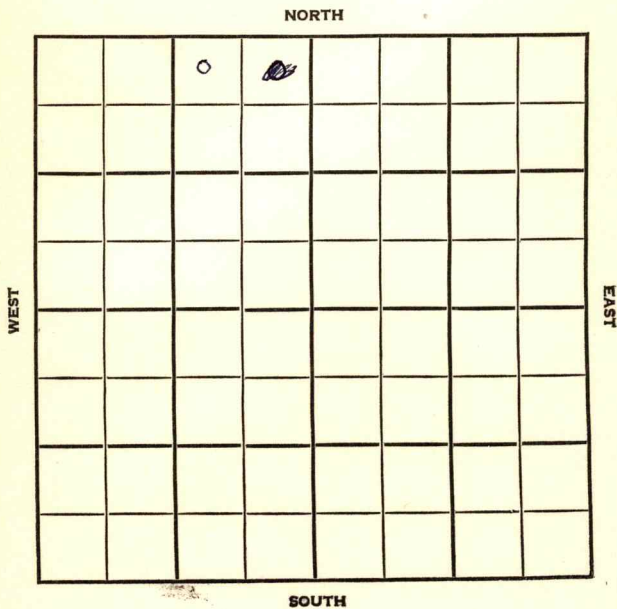


SEC.	TWP.	R.
24	32	12W

WELL NO. #1 Smith FARM

COMPANY Aurora Gasoline

CONTRACTOR Aylward
Wildcat

_____ Ft. from N. Line
 _____ Ft. from S. Line
 _____ Ft. from E. Line
 _____ Ft. from W. Line

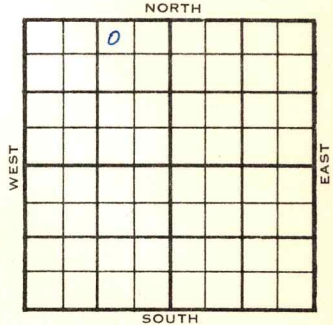

NW NE NW

1955	ELEVATION	REPORT
	1440'	

9/7 Location

10/5 Comm 9-16-55
 8 5/8" @ 134/125
 H 3506
 Dg 3522
 L 3694
 BKC 4132
 M 4266
 K 4428
 Chatta 4510
 V ~~4546~~ 4546
 S 4624
 TD 4627 4623
 DST 4616-23 open 2 hr Rec 8' socm
 239' sw 1860/30" DST 4268-86
 open 2 hr Rec 240' gas 30' sgcm
 50# DST 4546-50 open 1 1/2 hr Rec
 395' gas 25' gcm 480/30"
 D & A

ABANDONED

County Barber Elev. 1140
 Sec. 21 Twp. 32 Rge. 12W
 Company Aurora Gasoline
 Farm Name Smith No. 1

TOPS	DEPTH	LOG	DATUM
Anh.			
Tr.			
H.	3506		2066
Dg.	3522		2082
B.L.			
L.	3694		2254
K.C.			
B.K.C.	4132		2692
Ce.			
C.		4266	2826
M.			
M.		4428	2988
K.		4570	3070
Mz. <u>Chatta</u>			
Ma.			
V.		4546	3106
S.		4624	3184
S.			
A.			
R.			
Pf.			
G.			
T.D.	4627	4623	

Loc. in Sec. NW NE NW
 Geol. _____
 Contr. _____
 Pool Wildcat
Aylward



Date Comm. 9-16-55 **OCT** 5 1955

8 5/8" @ 13 1/2 125 DST 4616-23 open 2 hr.
Rec. 8' socm 239' sw 1860/30"
DST 4268-86 open 2 hr. Rec. 240' gas
30' sgcm 50# DST 4546-50 open 1 1/2 hr.
Rec. 395' gas 25' gcm 480/30"
D & A

Co.
 Lse.
 No.
 Sec.
 T.
 R.

County ~~Barber~~ Elev. _____

Sec. 24 Twp. 32 Rgs. 32W

Company Aurora Gasoline

Farm Name Smith No. 1

TOPS DEPTH LOG DATUM

Anh.			
Tp.			
H.			
Tr.			
Dg.			
Bl.			
L.			
K.C.			
B.K.C.			
Ce.			
C.			
M.			
M.			
K.			
Mz.			
Me.			
V.			
S.			
S.			
A.			
R.			
PE.			
G.			
T.D.			

Loc. in Sec. _____

NW NE NW

Geol. _____

Contr. _____

Aylward

Pool _____

Wildcat

0	
FIRST REPORT	
SEP	7 '50

Date Comm. _____

Location

~~Handwritten signature~~

Co.

Lse.

No.

Sec.

T.

R.