

Barber

KANSAS

SECTION 23 TOWNSHIP 32 RANGE 12W

WELL NO. #2 Bloomer

COMPANY Adair

NORTH

		0					

WEST

EAST

SOUTH

SEC. 23	TWP. 32	R. 12W
------------	------------	-----------


WELL NO. #2 Bloom FARM

COMPANY
Adair

CONTRACTOR
Co.Tools

Bloom

_____ FT. FROM N. LINE
 _____ FT. FROM S. LINE
 _____ FT. FROM E. LINE
 _____ FT. FROM W. LINE

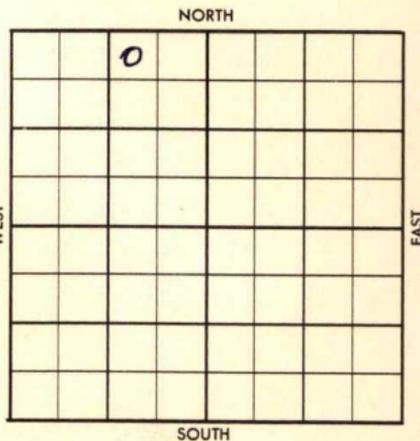

NW NE NW

1956	ELEVATION 1526' DF	REPORT
------	-----------------------	--------

5-23 Comm. 5-20-56
 8" @ 202 w/175
 Drlg. 900

8-15 DST 4320-60 op 2 hrs., 210' SGCM, 120' MSW, BHP 4490#
 DST 4699-4709 op 1 hr., rec. 180' GIP 185' G&OCM, 150/20".
 DST 4694-4714 op 2 hrs., 660' GIP, rec. 2790 G&SOCSW,
 5" @ 4714'
 72/4322-34
 Frac 10 x 10
 Ph P/ 10 bopd / 90% wtr.,
 Grav 35.
 Elg. 3381'; H. 3560'; BL. 3757'; #####
 L. 3763'; M. 4330';
 TD 4714',

COMPLETED

County Barber Elev. 29 R13
1526 DF
 Sec. 23 Twp. 32 Rge. 12W
 Company Adair
 Farm Name Bloom No. 2

TOPS	DEPTH	LOG	DATUM	Loc. in Sec.
Anh.				NW NE NW
TP				
H. <u>dg</u>	<u>3381</u>			
Tr. <u>12</u>	<u>3560</u>			
Dg.				
BL	<u>3757</u>			
L.	<u>3763</u>			
K.C.				Geol.
B.K.C.				Contr.
Ce.				Co. tools
C.				
M.	<u>4320</u>			Pool
M.				Bloom
K.				
Mz.				
Mq.				
V.				
S.				
S.				
A.				
R.				
PE.				
G.				
T.D.	<u>4714</u>			

0
 COMPLETE

Date Comm. 5-20-56 AUG 15 '56

8" @ 202/175 drlg. 900 MAY 29 '56 3169

JUN 6 '56 DST 4320-60 2 hrs

210' 56 CM 120' MSW, BHP

4490 JUN 13 '56 ~~JUN 20 '56~~

125T 4699-4709 open 1 hr.

180' 9" 185' glt

150/30" 0

13-32-12W

NW NE NW

4694-4714^{RFD} op 2ha/660'

GIP, R 2790 G±500SW, B 1580

5" 4714, WACT JUN 20 '56 JUN 27 '56

JUL 3 '56 JUL 11 '56 72/4322-34

JUL 18 '56 JUL 25 '56 AUG 7 '56 AUG 8 '56

Frac 10 x 10 & POP

AUG 15 '56 Ph P. 10 Bopd +

90% wts gran 35°

County Barber Elev. _____
 Sec. 23 Twp. 32 Rge. 12W
 Company Adair
 Farm Name Bloom No. 2

TOPS	DEPTH	LOG	DATUM	Loc. in Sec.
Anh.				NW NE NW
Tp.				
H.				
Tr.				
Dg.				
Bl.				
L.				Geol. _____
K.C.				Contr. _____
B.K.C.				Co. tools
Ce.				
C.				Pool
M.				Bloom
M.				
K.				
Mz.				
Me.				
V.				
S.				
S.				
A.				
R.				
PE.				
G.				
T.D.				

0	
FIRST REPORT	
MAY 23 56	

Date Comm. 5-20-56
8" @ 202/175 drlg. 900

3201 P. S. YAM

[Handwritten signature]

203

Co.
No.
Sec.
T.
R.