


Section 30 Township 32 Range 12WWell No. #4 Warren FeeCompany SKELLY OIL

NORTH

WEST

EAST

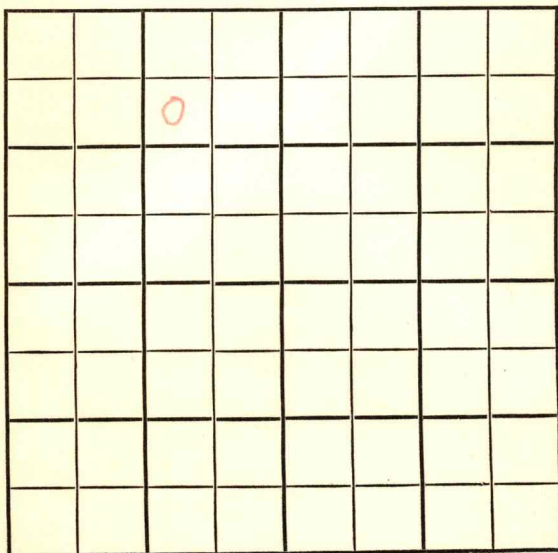

SOUTH

Barber

KANSAS

SEC.	TWP.	R.
30	32	12W

WELL NO.

4 Warren Fee

FARM

COMPANY

Skelly Oil

CONTRACTOR

Hulme tools

NE Medicine Lodge Pool

_____ Ft. from N. Line


_____ Ft. from S. Line

1098

_____ Ft. from E. Line

_____ Ft. from W. Line

SW NE NW

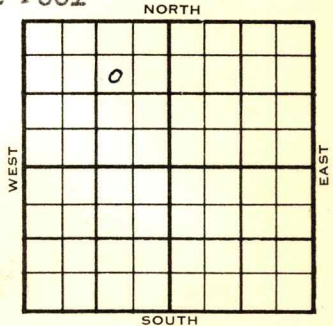

1955

ELEVATION

1664

REPORT

6/22

Comm 6-19-55

8" @ 318/200

7/27

Comm 6-19-55

H 3755, L 3938, BKC 4364, C Marm 4375,
Miss 4459,

TD 4538

8" @ 318/200 DST 4448-93 open 1 hr
gas in 22 min. Rec 170' so & gcm

800# 5 1/2" @ 4538/200 CO to 4500

108/4478-96 8 bw 6 hr 500 A

S/15 bo 9 hr frac S & F 20 bo 1 bw

5 hr F/50 bo 2 bw 6 hr

Comp F/98 bopd 3% wtr.

COMPLETED

County **Barber** Elev. _____
 Sec. **30** Twp. **32** Rge. **12W**
 Company **Skelly Oil**
 Farm Name **Warren Fee** No. **4**

TOPS	DEPTH	LOG	DATUM	Loc. in Sec.
Anh.				SW NE NW
Tp.				
H.				1098' EL
Tr.				
Dg.				
Bl.				
L.				Geol. _____
K.C.				Contr. _____
B.K.C.				Hulme tools
Ce.				
C.				Pool
M.				NE Medicine
K.				Lodge Pool
Mz.				FIRST REPORT JUN 22 55
Mq.				
V.				
S.				
S.				
A.				
R.				
Pe.				
G.				
T.D.				

Date Comm. **6-19-55**
8" @ 318/200

K-26

County Barber Elev. 1664
 Sec. 30 Twp. 32 Rge. 12W
 Company Skelly Oil
 Farm Name Warren Fee No. 4

TOPS	DEPTH	LOG	DATUM
Anh.			
Tp.			
H.	<u>3755</u>		<u>2091</u>
Tr.			
Dg.			
BL.			
L.	<u>3938</u>		<u>2274</u>
K.C.			
B.K.C.	<u>4364</u>		<u>2700</u>
Ce.			
C. <u>Marm</u>	<u>4375</u>		<u>2711</u>
M. <u>ss</u>	<u>4459</u>		<u>2795</u>
M.			
K.			
Mz.			
Mq.			
V.			
S.			
S.			
A.			
R.			
PE.			
G.			
T.D.	<u>4538</u>		

Loc. in Sec. _____

SW NE NW

1098' El

Geol. _____

Contr. _____

Hulme Drlg.

Pool _____

NE Medicine
Lodge

COMPLETE

Date Comm. 6-19-55 JUL 27 1955

8" @ 318/200 DST 4448-93 open 1 hr.

gas in 22 min. Rec. 170' so & gcm

800# 5 $\frac{1}{2}$ " @ 4538/200 C to 4500

108/ 4478-96 8 bw 6 hr. 500 A

S/ 15 bo 9 hr. frac

S & F/ 20 bo 1 bw 5 hr. F/ 50 bo

2 bw 6 hr. Comp. F/ 98 bopd 3% wtr.