


SECTION 29 TOWNSHIP 32S RANGE 12W

WELL NO. #1 Warwick

COMPANY Petroleum Inc.

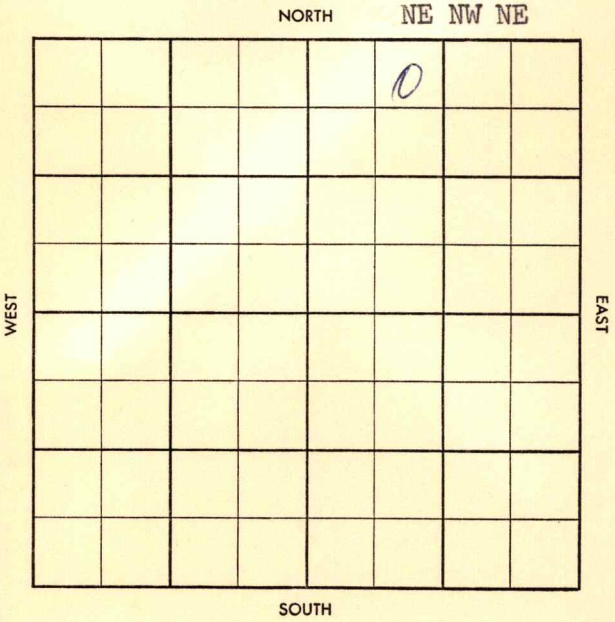

26

WILDCAT

S-513-B

County Barber Elev. _____
 Sec. 29 Twp. 32 Rge. 12W
 Company Petroleum Inc.
 Farm Name Warwick No. 1

TOPS	DEPTH	LOG	DATUM
Anh.			
Tp.			
H.			
Tr.			
Dg.			
B.L.			
L.			
K.C.			
B.K.C.			
Ce.			
C.			
M.			
M.			
K.			
Mz.			
Mq.			
V.			
S.			
S.			
A.			
R.			
Pf.			
G.			
T.D.			

Loc. in Sec. NE NW NE
 Geol. _____
 Contr. Garvey #5
 Pool Wildcat

JAN 29 1938
FIRST REPORT

Date Comm. MIRT

Co.
Lse.
No.
Sec.
T.
R.

County Barber Elev. 1603 or 1606
 Sec. 29 Twp. 32 Rge. 12W
 Company Petroleum Inc.
 Farm Name Warwick No. 1

TOPS	DEPTH	LOG	DATUM
Anh			
Tp. <u>Elgin</u>			
H.	<u>3670</u>		
Tf.			
Dp. <u>sd</u>	<u>3786</u>		
B.L.			
L.	<u>3860</u>		
K.C.			
B.K.C.	<u>4297</u>		
Ce.			
C.			
M.	<u>4410</u>		
M.			
K.			
Mz.			
Mq.			
V.			
S.			
S.			
A.			
R.			
Pf.			
G.			
T.D.	<u>4515</u>		

Loc. in Sec. NE NW NE

Geol. _____
 Contr. _____
Garvey #5

Pool Wildcat



Date Comm. 1-29-58
 MIRT FEB 6 '58 8° 517/325 Ø 3100

FEB 12 58 DST 4407-30 60" 30'M
BHP 0 1/2 DST 4430-50 60"
180' gip 40' gem spk. oil
BHP 0 1/2 Ø 4470 FEB 19 '58 DST 4450-80
60" 50' gip 50' V 5 gem BHP 0 1/2
SPD DST 4480-4515 60" 15'M
all P O no log
DDA

Co. No. L. Sec. No. Sec. T. R.