

Barber

KANSAS

SECTION 30 TOWNSHIP 32 RANGE 12 W

WELL NO. #1 Wadsworth

COMPANY Schie Pet.

NORTH

0							

WEST

EAST

SOUTH

Barber

KANSAS

SEC. 30	TWP. 32	R. 12W
------------	------------	-----------


WELL NO. #1 Wadsworth FARM

COMPANY
Sohio Petr.

CONTRACTOR
Garvey

N. Medicine Lodge

_____ Ft. from N. Line
 _____ Ft. from S. Line
 _____ Ft. from E. Line
 _____ Ft. from W. Line

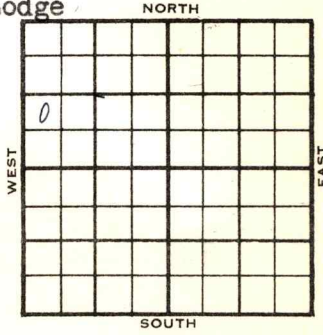

NW SW NW

1955	ELEVATION	REPORT
------	-----------	--------

12-21	Comm. 12-15-55 8" @ 321/200 Drlg. 2400	
-------	--	--

County Barber Elev 1663
 Sec. 30 Twp. 32 Rge. 12W
 Company Solo Pt.
 Farm Name Wadsworth No. 1

	TOPS	DEPTH	LOG	DATUM	Loc. in Sec.
Ans.					NW SW NW
TP					
H.		3756		2093	
Te					
De		3834		2171	
Bl					
L		3935		2272	
Kc	Marm	4372		2709	Geol.
SEC.					Conts
Co.					
C.					Garry
M.		4458	4456	2793	Pool
H.					M. Medicine L
Mr.					
Ms.					
V.					
S.					
A.					
R.					
PC.					
G.					
TR		4520			

o
COMPLETE

Date Com. 12-15-55 FEB 22 1956

8" @ 221/200 drlg. 2400 sec 28 '55 JAN 5 '56
 DST 4449-85 60" 9 in 37"
 90 62 MCF in 60" sec 30'
 505 GCM + 130' 405 GCM + 270'
 934 oil BHP 1370/20 5 1/2 452
 1125 JAN 11 '56 co 4516 48/4482-94
 10 6 20 + 15 Gwph Frac
 JAN 18 '56 8 59 B0 + 10 BW 5 hrs
 W0 Pt. JAN 25 '56 9 67 B0 + 10 70 W

FEB 1 '56 FEB 8 '56 ✓ FEB 15 '56 FEB 22 '56 P.H.P.

56 Bopd + 20% wtw.

R.G.

MAR 1 1956

County Barber Elev. _____
 Sec. 30 Twp. 32 Rgs. 12W
 Company Sohio Pet.
 FarmName Wadsworth No. 1

TOPS	DEPTH	LOG	DATUM
Anh.			
Tp.			
H.			
Tr.			
Dg.			
B.L.			
L.			
K.C.			
B.K.C.			
Ce.			
C.			
M.			
M.			
K.			
Mz.			
Mq.			
V.			
S.			
S.			
A.			
R.			
Pe.			
G.			
T.D.			

Loc. in Sec. NW SW NW
 Geol. _____
 Contr. Garvey
 Pool N. Medicine Lodge

FIRST REPORT
 DEC 21 '55

Date Comm. 12-15-55
8" @ 321/200 drlg. 2400

Handwritten signature

Co.
Lse.
No.
Sec.
T.
R.