

Section 30 Township 32 Range 12 W

Well No. # 1 Warren Fee

Company Skelly Oil

NORTH

	0						

WEST

EAST

SOUTH

Barber KANSAS

SEC. 30 TWP. 32 R. 12W

WELL NO. 1 Warren Fee FARM

COMPANY Skelly Oil

CONTRACTOR Garvey


N. Medicine Lodge

330 Ft. from N. Line

Ft. from S. Line

Ft. from E. Line

330 Ft. from W. Line

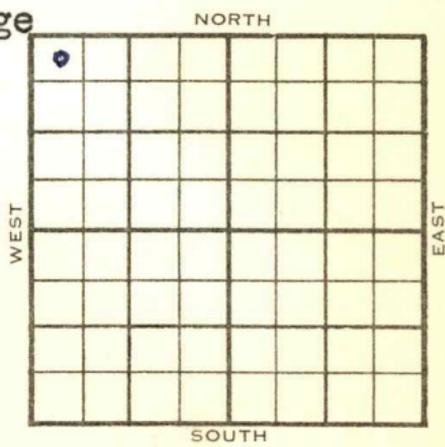

NW NW NW

1954 ELEVATION 1667' REPORT

11/23 Location

1955  
1/5

Spud 12-2-54 Oil well TD 4515'  
 8" @ 500 Heeb 3744 Ireland sd 3756  
 DST 3752-70 open 1/2 hr rec 15' drlg.  
 mud. 1208# Lans. 3921' B KC 4355  
 Marm. 4366 Miss. 4454  
 DST 4446-4515, open 1 1/2 hr gas in 3  
 min. 340,000 CFG F/oil in 1 hr.  
 F/5 BOPH 1585# TD 4515 5" @ 4515  
 CO to 4503 102/4464-81 F/40 BO  
 5 hr. 250 A S/18 BO 3 BAW 3 hr.  
 sd-oil-frc. F/200 BO 20 BW 15 hr.  
 Comp. F/251 BOPD 6% wtr.

COMPLETED

County Barber State Kansas  
 Sec. 30 (Blk. 32) (Sur. 12W) (Twp.) (Rge.) Map No.  
 Operator Skelly Oil  
 Well No. 1 Farm Warren Fee  
 Elev. 1667 Location NW NW NW

0				

330 Ft. From N Line NW  
330 Ft. From W Line Quarter  
 1st. Report  
 Completion JAN 5 1955  
 Remarks N. Medicine Lodge  
Garvey - Contr.  
 Spudding Date 12-2-54

Drlg. Data Oil well TD 4515  
8" @ 500 Heeb. 3744 Ireland sd. 3756  
DST 3752-70 open 1/2 hr. Rec. 15' drlg.  
mud 1208# Lans. 3921 B KC 4355  
Marm. 4366 Miss. 4454 DST 4446-4515  
open 1 1/2 hr. gas in 3 min. 340,000 cfg  
F/ oil in 1 hr. F/ 5 boph 1585#  
TD 4515 5" @ 4515 CO to 4503  
102/ 4464-81 F/ 40 bo 5 hr. 250 A  
S/ 18 bo 3 baw 3 hr. sd-oil-frac  
F/ 200 bo 20 bw 15 hr.  
Comp. F/ 251 bopd 6% wtr.

EAREN GILSTRAP

County **Barber** State **Kansas**

Sec. **30** (Blk.) **32** (Sur.) **12W** Map No.

Operator **Skelly Oil**

Well No. **1** Farm **Warren Fee**

Elev. \_\_\_\_\_ Location **NW NW NW**

0					

**330** Ft. From **N** Line **NW**

**330** Ft. From **W** Line Quarter

1st. Report **NOV 23 1954**

Completion **NOV 23 1954**

Remarks \_\_\_\_\_

Spudding Date \_\_\_\_\_

Drlg. Data **N. Medicine Lodge**

**Location**



**FABEN GILSTRAP**