


Section 33 Township 32 Range 12W

Well No. 1 Barthalow

Company Rupp-Ferguson & O. H. Parker

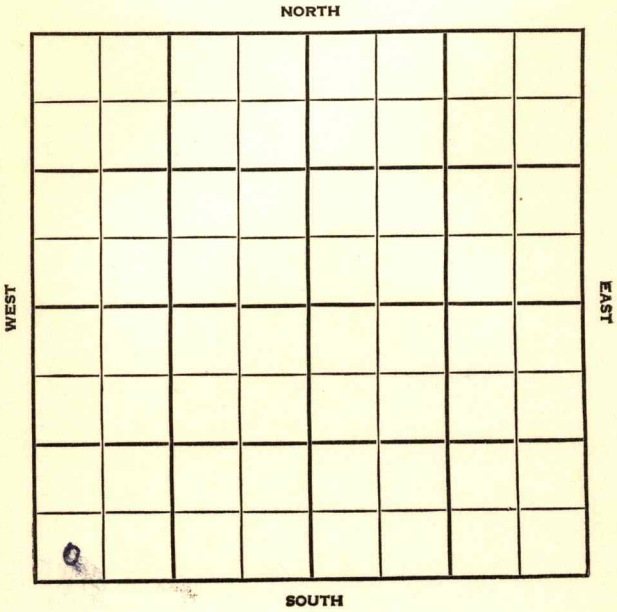


SEC.	TWP.	R.
33	32	12W

WELL NO. #1 Barthalow FARM

COMPANY Rupp-Ferguson & O.H. Parker.

CONTRACTOR Co. Tools.

Wildcat.
 _____ Ft. from N. Line
 330 _____ Ft. from S. Line
 _____ Ft. from E. Line
 330 _____ Ft. from W. Line

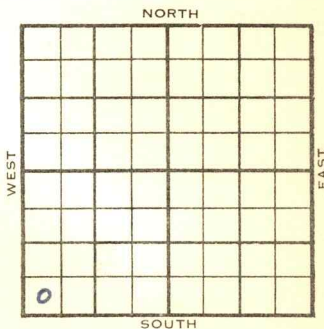

SW SW SW
 Skelly - DHM

	ELEVATION	REPORT
--	-----------	--------

1955

1603'

4/20

Spud 4-14-55
 8" @ 263'
 Drlg. 2320'

7/7

DST 3713-40 open 1 hr. Rec 30' sgcm 980
 /20" DST 3750-3802 open 1 hr. Rec. 90'
 vsgcm 920/20" DST 4435-60 open 1 1/2 hr. g
 gas to surface in 3 min 1,500mcfg 75
 gcm 1440# DST 4706-12 open 1 hr. Rec.
 70' muddy wtr. 2000# DST 4808-46 open
 1/2hr Rec. 15' mud 5 1/2" @4549 Co 24/
 4440-46 549 mcfg frac F/8,000 mcfg 8,8
 00 mcfg Comp. shut ingas well 6,124
 mcfgpd.

Tops:	Depth	Datum
H.	3695	2092
Dg.	3706	2103
L.	3874	2271
M.	4434	2831
V.	4705	3102
S2	4808	3205
TD	4889	

COMPLETED

County Barber Elev. 1603
 Sec. 33 Twp. 32 Rge. 12W
 Company Rupp-Ferguson & O. H. Parker
 Farm Name Bartholow No. 1

TOPS	DEPTH	LOG	DATUM
Anh.			
TP.			
H.	<u>3695</u>		<u>2092</u>
Tr.			
Dg.	<u>3706</u>		<u>2103</u>
Bl.			
L.	<u>3874</u>		<u>3271</u>
K.C.			
B.K.C.			
Ce.			
C.			
M.	<u>4434</u>		<u>2831</u>
M.			
K.			
Mz.			
Me.			
V.	<u>4705</u>		<u>3102</u>
S.	<u>4808</u>		<u>3205</u>
S.			
A.			
R.			
PE.			
G.			
T.D.	<u>4889</u>		

Loc. in Sec. SW SW SW

Geol. _____

Contr. _____

Pool _____

Medicine Lodge

COMPLETE		

Date Comm. 4-14-55 JUL 6 1955

8" @ 263/205 DST 3713-40 open 1 hr.

Rec. 30' sgcm 980/20" DST 3750-3802

open 1 hr. Rec. 90' vsgcm 920/20"

DST 4435-60 open 1 1/2 hr. gas to surface

in 3 min. 1,500 mcfg 75' gcm 1440#

DST 4706-12 open 1 hr. Rec. 70' muddy

wtr. 2000# DST 4808-46 open 1/2 hr.

Rec. 15' mud 5 1/2" @ 4549 CO

OVER

24/ 4440-46 549 mcfg frac F./ 8,000

mcfg 8,800 mcfg

Comp. shut in gas well 6,124 mcfgpd

.....	Misc.
.....	Pierce Map
.....	France Map
.....	Tracings
.....	Land Wall Map
.....	Land Small Map
.....	Scout Cards

JS

JUL 15 1955