

Section 2 Township 32 Range 12 WWell No. # 1 Smith "D"Company Musgrove Pet.

NORTH

WEST

EAST

SOUTH

0

Barber KANSAS

SEC.	TWP.	R.
2	32	12W

WELL NO. 1 Smith "D" FARM

COMPANY Musgrove Petr.

CONTRACTOR Co. Tools
SW Whelan Pool


_____ Ft. from N. Line

330 _____ Ft. from S. Line

_____ Ft. from E. Line

990 _____ Ft. from W. Line

SE SW SW

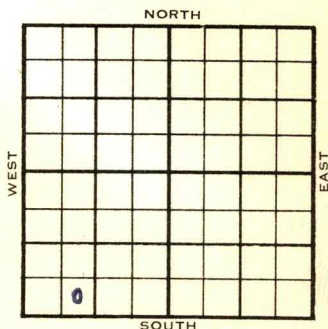


	ELEVATION	REPORT
1954	1460'	

11/3 MIR

12/1 Spud 11-3-54 Temp. Abd.
 TD 4321 8-5/8" @ 270 Elgin 3358
 DST 3358-68 open 1½ hr rec 130' wtr.
 300# Heeb 3492 Doug. 3559
 DST 3634-44 open 20 min rec 4' mud
 off Lans. 3667 Miss 4220
 DST 4220-34 gas in 3 min, 450,000 CFG
 30' GCM 1505#
 DST 4225-39 open 1 hr rec 30' GCM
 1515# TD 4238 5" @ 4238
 BD 4310 DD 4321 PB 4229
 15/4220-25 frac 91,000 CFGPD
 Temp. abd.

ABANDONED

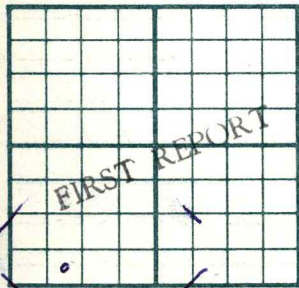County **Barber** State **Kansas**Sec. **2** (Blk.) **32** (Sur.) **12W** Map No.Operator **Musgrove Pet.**Well No. **1** Farm **Smith "D"**Elev. Location **SE SW SW****330** Ft. From **S** Line **SW****990** Ft. From **W** Line Quarter1st. Report **NOV 3 1954**

Completion


Remarks

Co. tools

Spudding Date

Drlg. Data **SW Whelan Pool****M I R****FABEN GILSTRAP**

County Barber State Kansas
 Sec. 2 (Blk. 32 (Sur. 12W Map No.
 (Twp. Rge.)
 Operator Musgrove Pet.
 Well No. 1 Farm Smith "D"
 Elev. 1460 Location SE SW SW

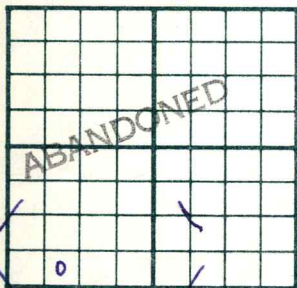

330 Ft. From S Line SW
990 Ft. From W Line Quarter

1st. Report

Completion DEC 1 1954

Remarks SW Whelan Pool

Co. tools

Spudding Date 11-3-54

Drlg. Data Temp. abd. TD 4321

8 5/8" @ 270 Elgin 3358 DST 3358-68

open 1 1/2 hr. Rec. 130' wtr. 300#

Heeb. 3492 Doug. 3559 DST 3634-44

open 20 min. Rec. 4' mud 0#

Lans. 3667 Miss. 4220 DST 4220-34

gas in 3 min. 450,000 cfg 30' gcm

1505# DST 4225-39 open 1 hr. Rec.

30' gcm 1515# TD 4238 5" @ 4238

DD 4310 DD 4321 PB 4229 15/ 4220-25

frac 91,000 cfgpd Temp. abd.

FABEN GILSTRAP