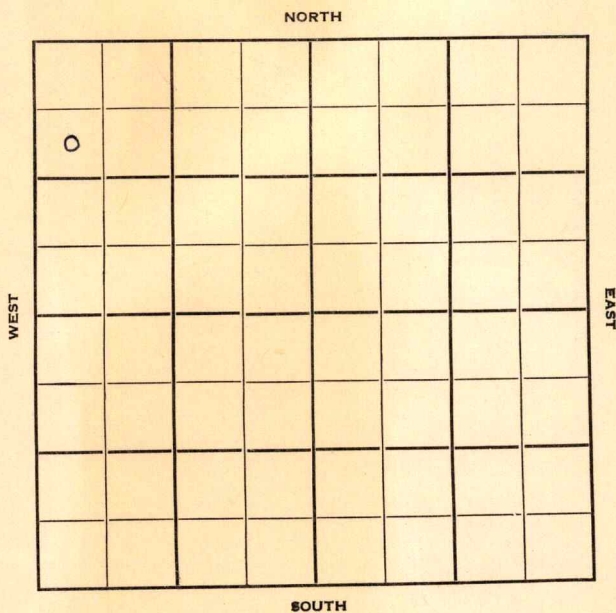


Section 2 Township 32 Range 12-WWell No. #1 BenefieldCompany Beardmore et al

Barber

KANSAS

Sec. 2 Twp. 32 R. 12W ✓

Well No. #1 Benefield Farm

Beardmore et al

Company

Contractor

Wildcat


990' Ft. from N. Line

Ft. from S. Line

Ft. from E. Line

330' Ft. from W. Line

SW NW NW

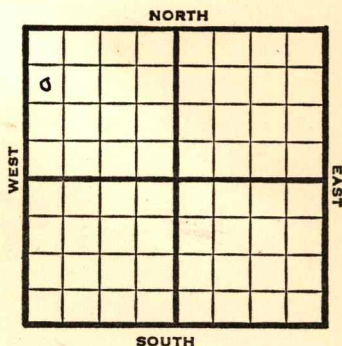

1950

Elev 1517

REPORT

6/14

Location

8/9

8" @ 160

Elgin 3371

DST 3375-82 opn 20 min rec 450' SW

Douglas 3657

Lans 3680

Miss 4285

Viola 4532

Simp 4619

DST 4619-48 opn $\frac{1}{2}$ hr rec 60' salty mud

Arb 4718-72 TD

D&A

ABANDONED

Kansas

Wildcat

Map No. _____ Sec. 2 Twp. 32 R. 12WWell No. 1 BenefieldBeardmore etal.

Company

Contractor

SW NW NW

SECTION PLAT

990 Ft. from N. Line

_____ Ft. from S. Line

_____ Ft. from E. Line

330 Ft. from W. Line

Barber County

Superior DHM

Location X

Rig up _____

Drilling and Remarks:

RECORD

Cased _____ in., _____ ft.

Sand _____

Gas _____

Oil _____

Total Depth _____

PRODUCTION

1st 24 hrs. Nat. _____

1st 24 hrs. after shot _____

Gas _____ Cu. Ft.

Dry Hole _____

Abandoned _____

Date

JUN 14 1950 19J. E. TYRA Scout

County Barber State KansasSec. 2 (Blk.) 32 (Sur.) 12W Map No.Operator Beardmore et al.Well No. 1 Farm BenefieldElev. 1517 Location SW NW NW990 Ft. From N Line NW330 Ft. From W Line Quarter

1st. Report

Completion AUG 9 1950

Remarks

Spudding Date

Drlg. Data Wildcat8" @ 160 Elgin 3371 DST 3375-82open 20 min. Rec. 450' swDouglas 3657 Lans. 3680 Miss. 4285Viola 4532 Simp. 4619 DST 4619-48open $\frac{1}{2}$ hr. Rec. 60' salty mudArb. 4718-72 TD D & A