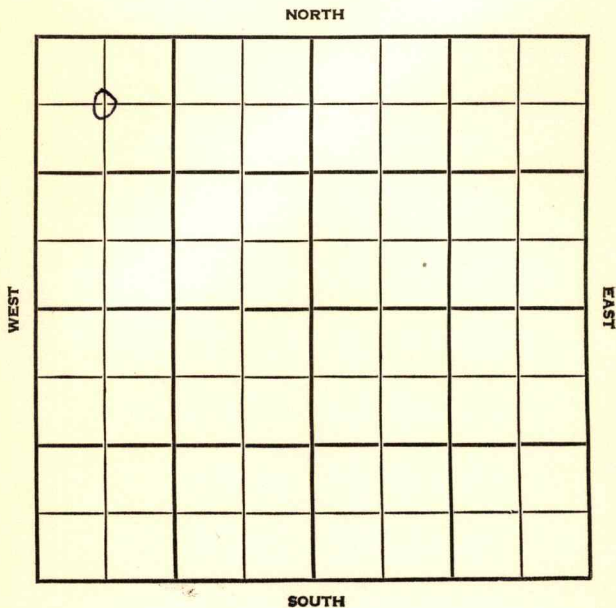


Section 6 Township 32 Range 12 WWell No. #1 WilsonCompany Pryor & Tracy

Barber

KANSAS

SEC.	6	TWP.	32	R.	12 W
------	---	------	----	----	------

WELL NO.

#1 Wilson

FARM

COMPANY

Pryor & Tracy

CONTRACTOR

D & M


WC

_____ Ft. from N. Line

_____ Ft. from S. Line

_____ Ft. from E. Line

_____ Ft. from W. Line

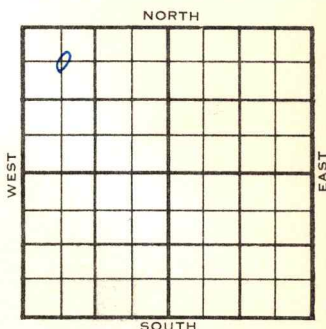

C NW NW

Carter AcP Magnolia AC Barbara & Sohio DHM

1955

ELEVATION

1502'

REPORT

9/28

Comm 9/28/55
 8" 201 w/150
 D 2615

10/19

Comm 9-22-55
 8" @ 201

H	3476	3485
Tr		3495
Dg	3551	3548
Bl	3655	
L	3666	3671
C	4185	
M	4210	
Chatta	4403	
sh	4336	4354
Mz	4420	
V	4429	4452
sh	4520	4532
Sd	4534	4541
A	4620	4647
TD	4700	

DST 3553-83 open 1 hr Rec 300' sw
 1310/20" DST 3617-50 open $\frac{1}{2}$ hr Rec
 660' sw 1360# DST 4190-4230 failed
 DST 4284-97 open 40 min. Rec 70'
 rotary mud 0/20"
 D & A

ABANDONED

County **Barber**

Elev. _____

Sec. **6**Twp. **32**Rge. **12W**Company **Pryor & Tracy**FarmName **Wilson**No. **1**

TOPS

DEPTH

LOG

DATUM

Loc. in Sec. _____

Anh. _____

Tp. _____

H. _____

Tr. _____

Dg. _____

Bl. _____

L. _____

K.C. _____

B.K.C. _____

Ce. _____

C. _____

M. _____

M. _____

K. _____

Mz. _____

Mq. _____

V. _____

S. _____

S. _____

A. _____

R. _____

P.E. _____

G. _____

T.D. _____

C NW NW

Geol. _____

Contr. _____

D & M

Pool _____

W.C.**FIRST REPORT****SEP 28 1955**Date Comm. **Carter (AcP) Magnolia (AC)****Barbara & Sohio (DHM)****9/22/55, 8" 201 W/150 D 2615****26**

County Barber Elev. 1502
 Sec. 6 Twp. 32 Rge. 12W
 Company Pryor & Tracy
 Farm Name Wilson No. 1

TOPS	DEPTH	LOG	DATUM
Anh.			
Tp.			
H.	<u>3476</u>	<u>3485</u>	<u>1983</u>
Tr.		<u>3495</u>	<u>1993</u>
Dg.	<u>3551</u>	<u>3548</u>	<u>2046</u>
BL.	<u>3653</u>		<u>2153</u>
L.	<u>3666</u>	<u>3671</u>	<u>2169</u>
K.C.			
B.K.C.			
Ce.			
C.	<u>4185</u>		<u>2683</u>
M.	<u>4210</u>		<u>2708</u>
M. <u>Chatter</u>	<u>4403</u>		<u>2901</u>
K. <u>sh</u>	<u>4336</u>	<u>4354</u>	<u>2852</u>
Mz.	<u>4420</u>		<u>2918</u>
Mq.			
V.	<u>4429</u>	<u>4452</u>	<u>2950</u>
S. <u>sh</u>	<u>4526</u>	<u>4532</u>	<u>3030</u>
S. <u>sd.</u>	<u>4534</u>	<u>4541</u>	<u>3039</u>
A	<u>4620</u>	<u>4647</u>	<u>3145</u>
R.			
Pe.			
G.			
T.D.	<u>4700</u>		

Loc. in Sec.

C NW NW

Geol.

Contr.

D & M Drllg

Pool

Wildcat

Date Comm. 9-22-55 OCT 19 1955

8" @ 201 DST 3553-83 open 1 hr.

Rec. 300' sw 1310/20" DST 3617-50

open $\frac{1}{2}$ hr. Rec. 660' sw 1360#

DST 4190-4230 failed DST 4284-97

open 40 min. Rec. 70' rotary mud 0/20"

D & A