

Barber

KANSAS

7

32

12W

SECTION _____ TOWNSHIP _____ RANGE _____


#1 Aubley

WELL NO. _____

Sierra

COMPANY _____

NORTH

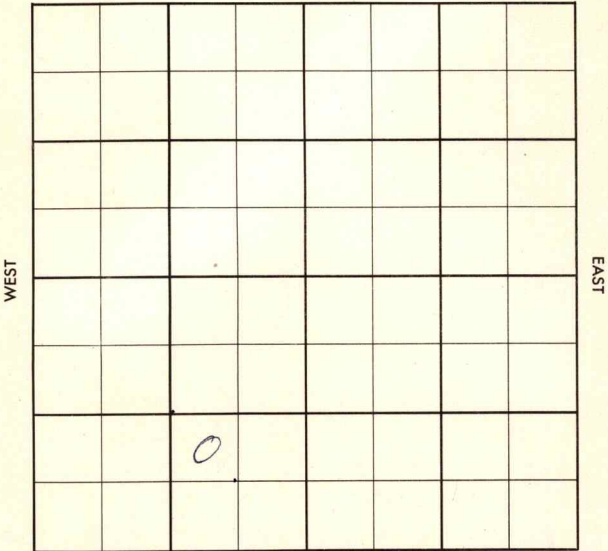

SOUTH

County Barber Elev. _____
 Sec. 7 Twp. 32 Rge. 12W
 Company Sierra
 Farm Name Aubley No. 1

TOPS	DEPTH	LOG	DATUM	Loc. in Sec. _____
Anh.				NW SE SW
Tr.				
Dg.				
BL.				
L.				
K.C.				Geol. _____
B.K.C.				Contr. _____
Ce.				/Co. Tools
C.				
M.				
M.				Pool
K.				Wildcat
Mz.				
Mq.				
V.				
S.				
S.				
A.				
R.				
Pe.				
G.				
T.D.				

FIRST REPORT
 SEP 19 '56

Date Comm.

Location SEP 26 '56

SEP 5 '56

R.G.R.

County Barber Elev. 1534 KB
 Sec. 7 Twp. 32 Rge. 12W
 Company Sierra
 Farm Name Aubley No. 1

TOPS	DEPTH	LOG	DATUM	Loc. in Sec.
Anb.	1404			NW SE SW
Tr.				
H.				
Tr.				
Dg.				
Bl.				
L.	3720			Geol.
K.C.				Contr.
B.K.C.	4138			/Co. Tools
Ce.				Pool Forsyth
C.				Wildest
M.	4246	4254		
M.				
K.				
Mz.				
Mo.				
V.				
S.				
S.				
A.				
R.				
Pe.				
G.				
T.D.	4328			

ABANDONED

OCT 1 9 1956

Date Comm. 50 h 0 F.O.Location SEP 26 '56 9-21-5685/2 221/135D 2805 OCT 3 '56 D 4249 OCT 10 '56 DST4254-74 1hr rec 10' D MdAll press 0 DST 4274-43091hr rec 50' D Md 1711 pr.0 DST 4296-4328 45" rec.25' D Md BHPDDEA